


Donald P. Orr.  
Union, Oregon

Sept 16, 1971

Scale 1" = 100'

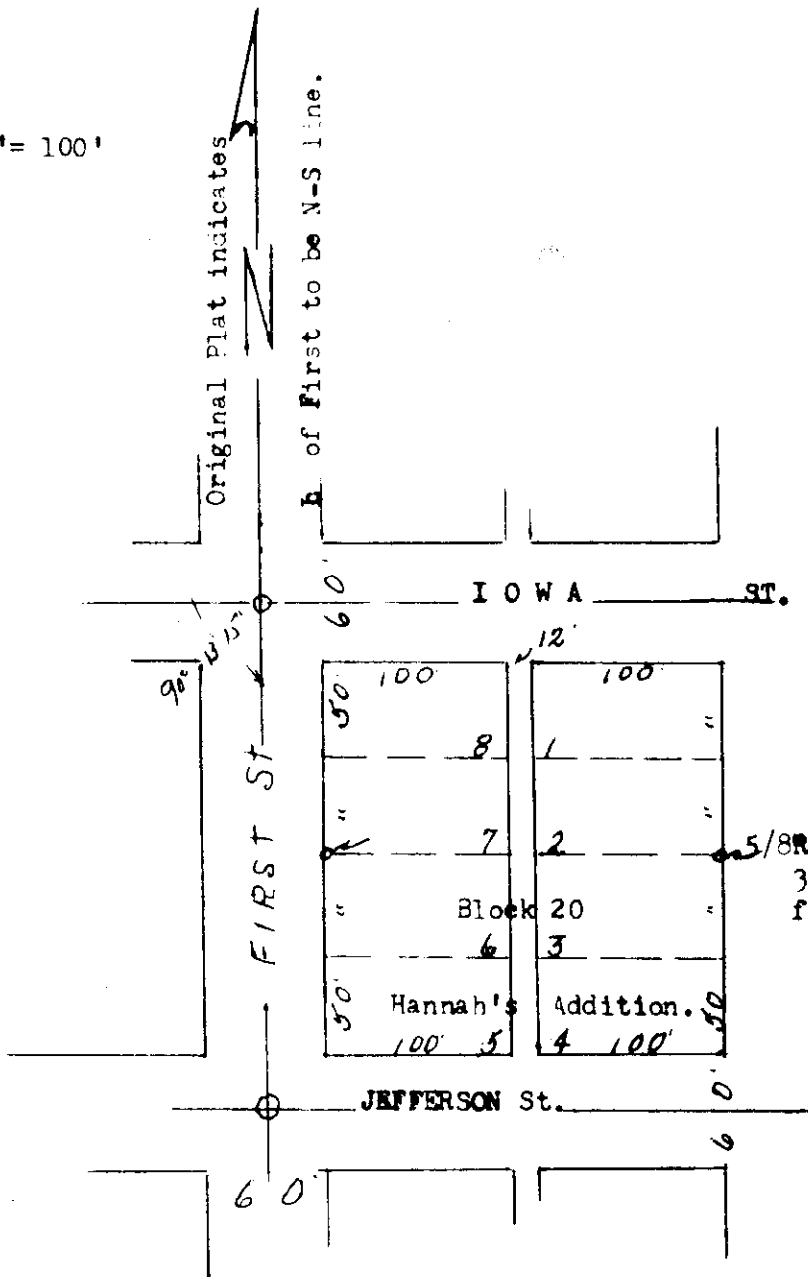

REGISTERED  
OREGON  
LAND SURVEYOR  
*James G. Voelz*  
MAY 4, 1968  
JAMES G. VOELZ  
381

17-29 6/1/1971