

John Schwendemann
 Rt. #1
 Box 107B
 Summerville, Oregon.


Oct 16, 1971

Description;

All of lots 23 and 24 and the east 9 feet of lot 25 of Block 5 of Predmores Addition to La Grande, Oregon.

- ✓ set 5/8" X30" steel rod.
- () data of record.

scale 1" = 100'

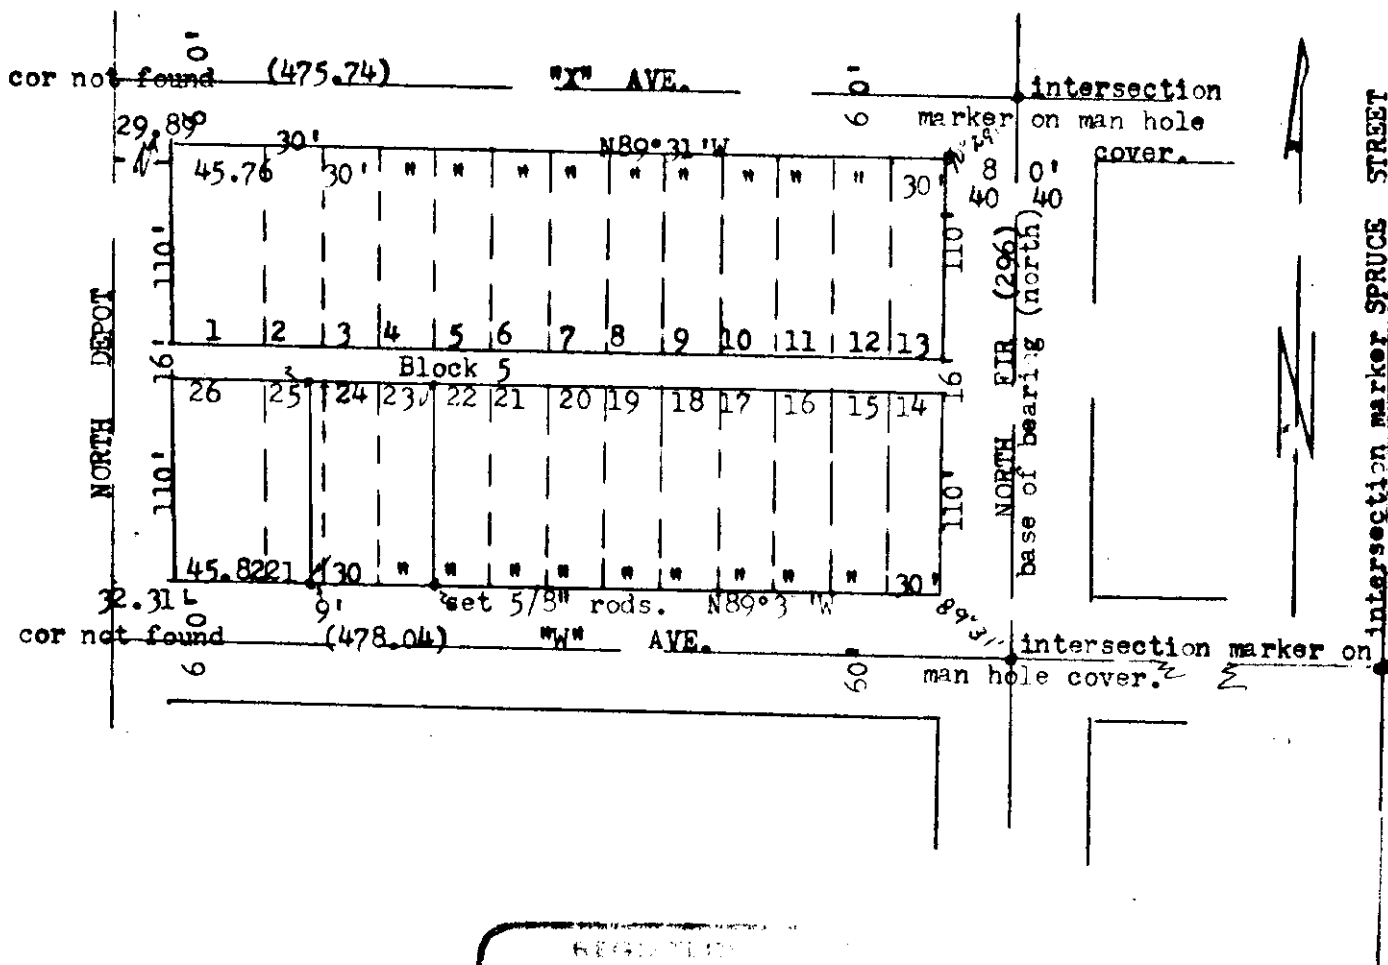

REGISTERED
 OREGON
 LAND SURVEYOR
James G. Vollen
 MAY 4 1956
 JAMES G. VOLLEN
 381