


Vernon N. Lund
540 Cedar St.
Elgin, Oregon

Oct. 15, 1971

Description;
Lots 7, 8, and 9 of Block 12 of North Elgin Addition
to Elgin, Oregon

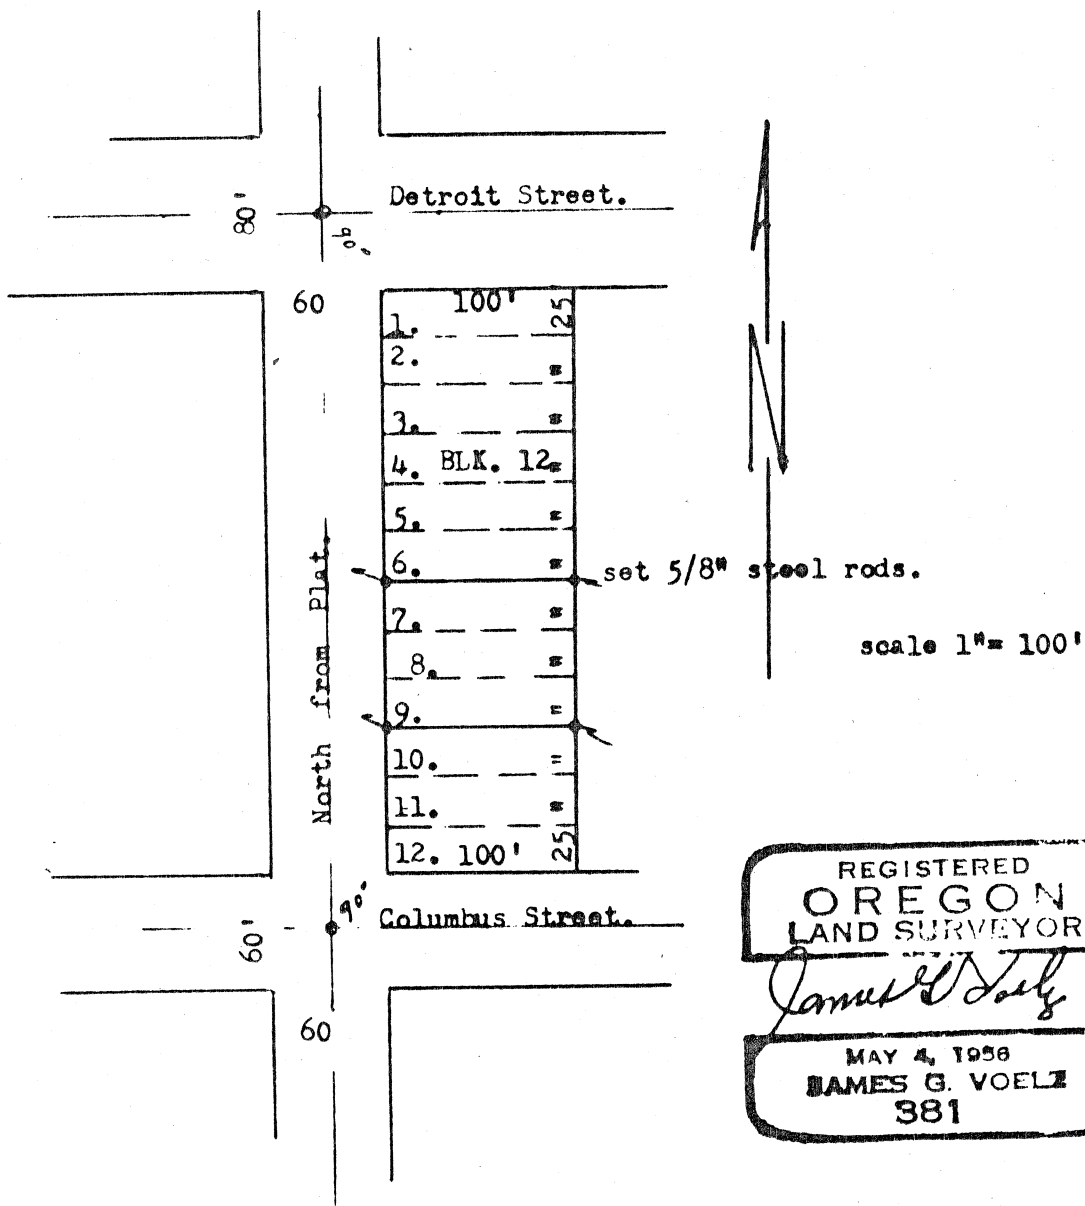

70-1971