


Sept. 15, 1971

scale 1"=200'

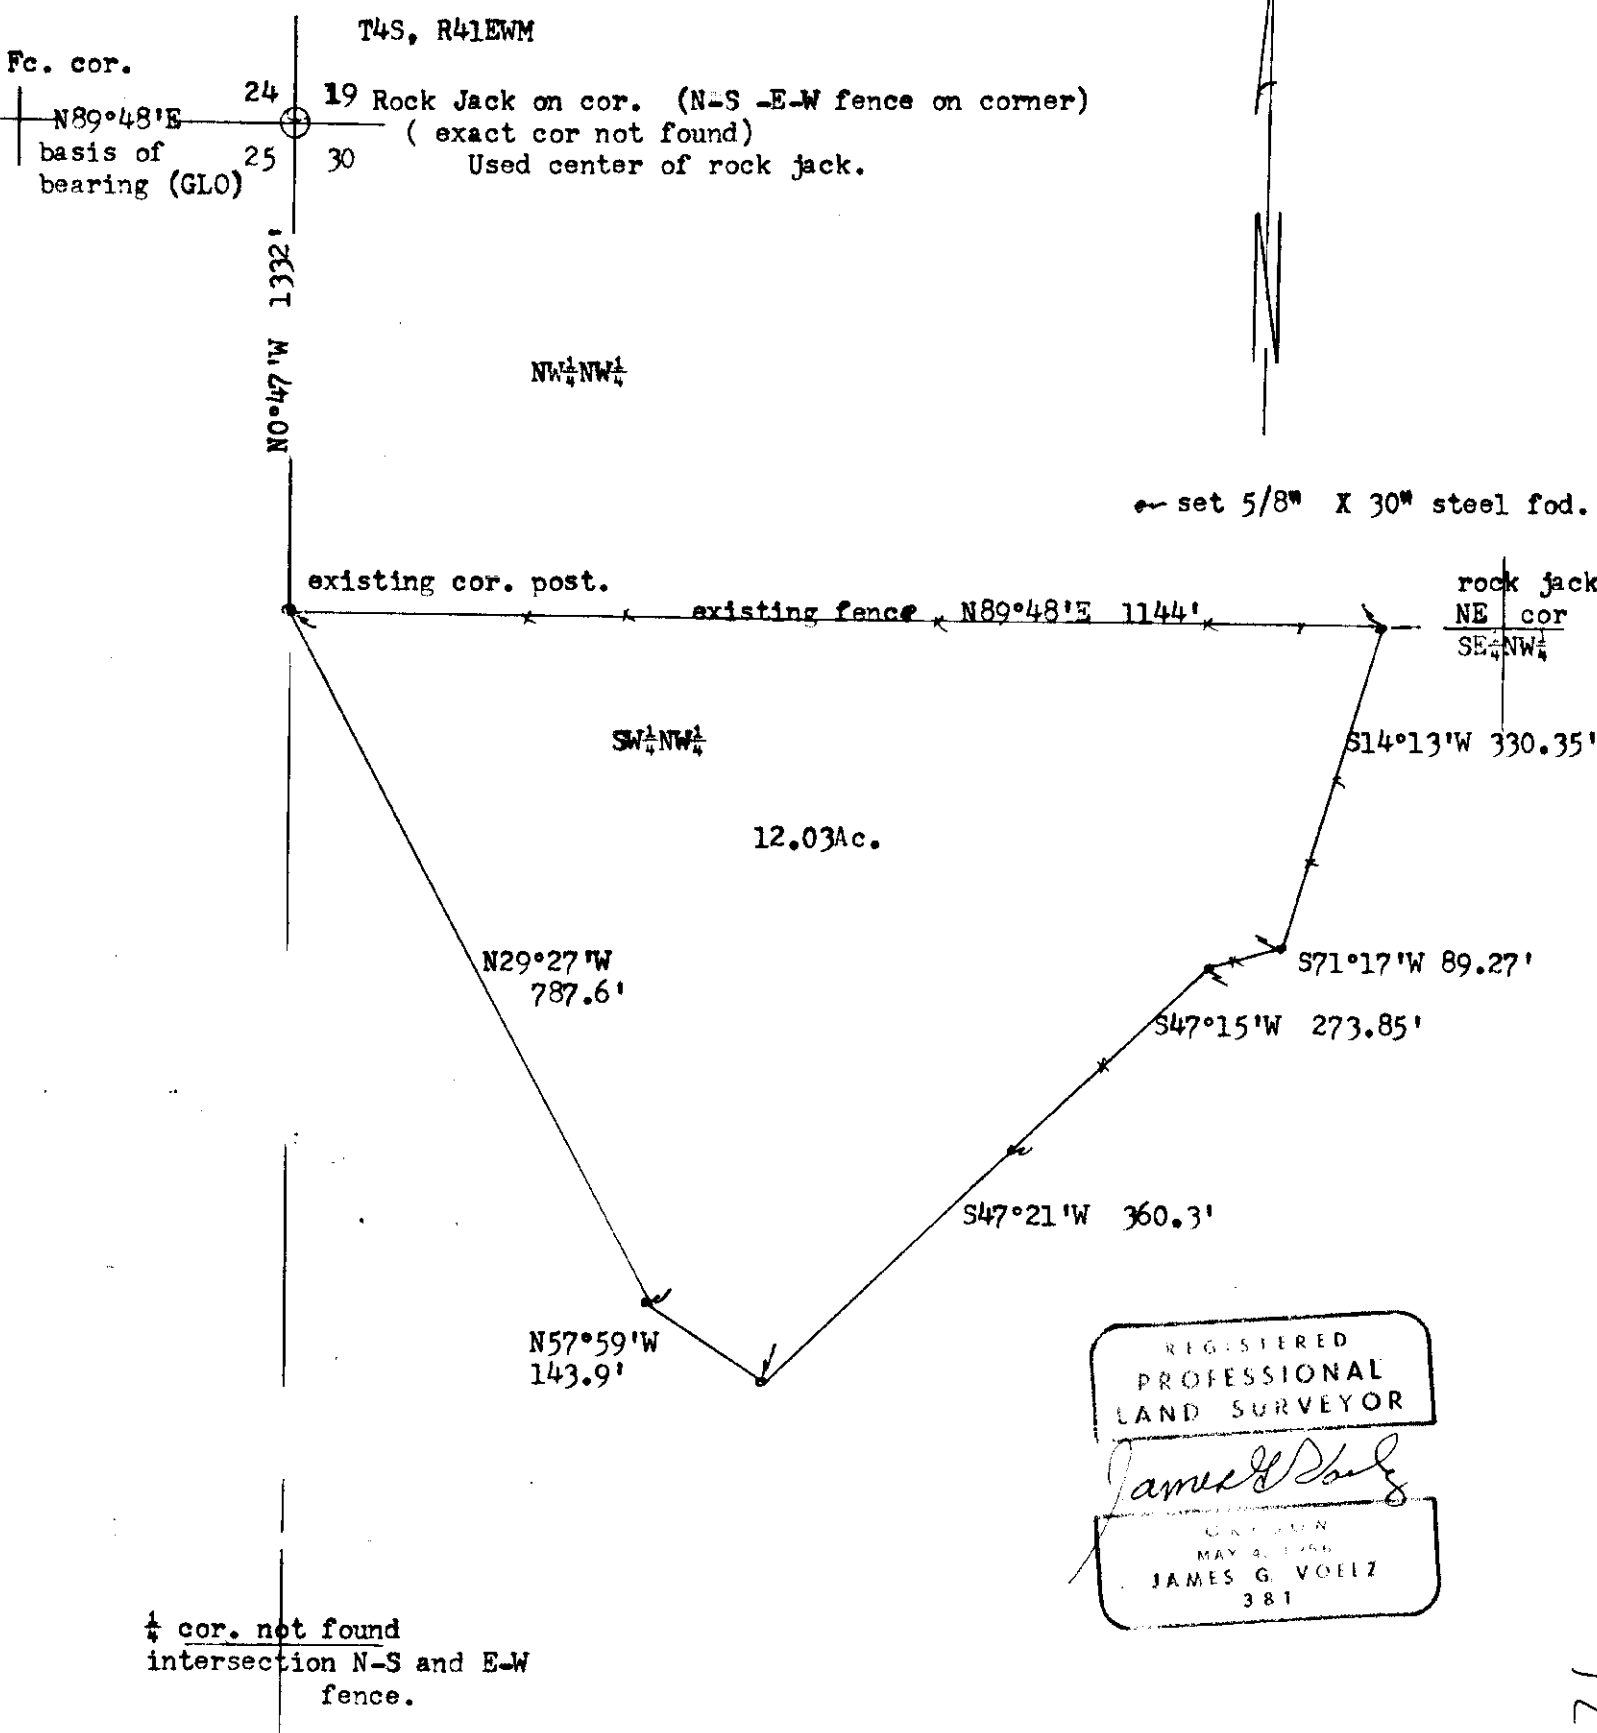

REGISTERED
PROFESSIONAL
LAND SURVEYOR

James G. Voelz

CREATED
MAY 4, 1966
JAMES G. VOELZ
381

73-71