


Clifford Needham
Rt. #1 Box 1719
La Grande, Oregon

May 7, 1971

Scale 1"=200'

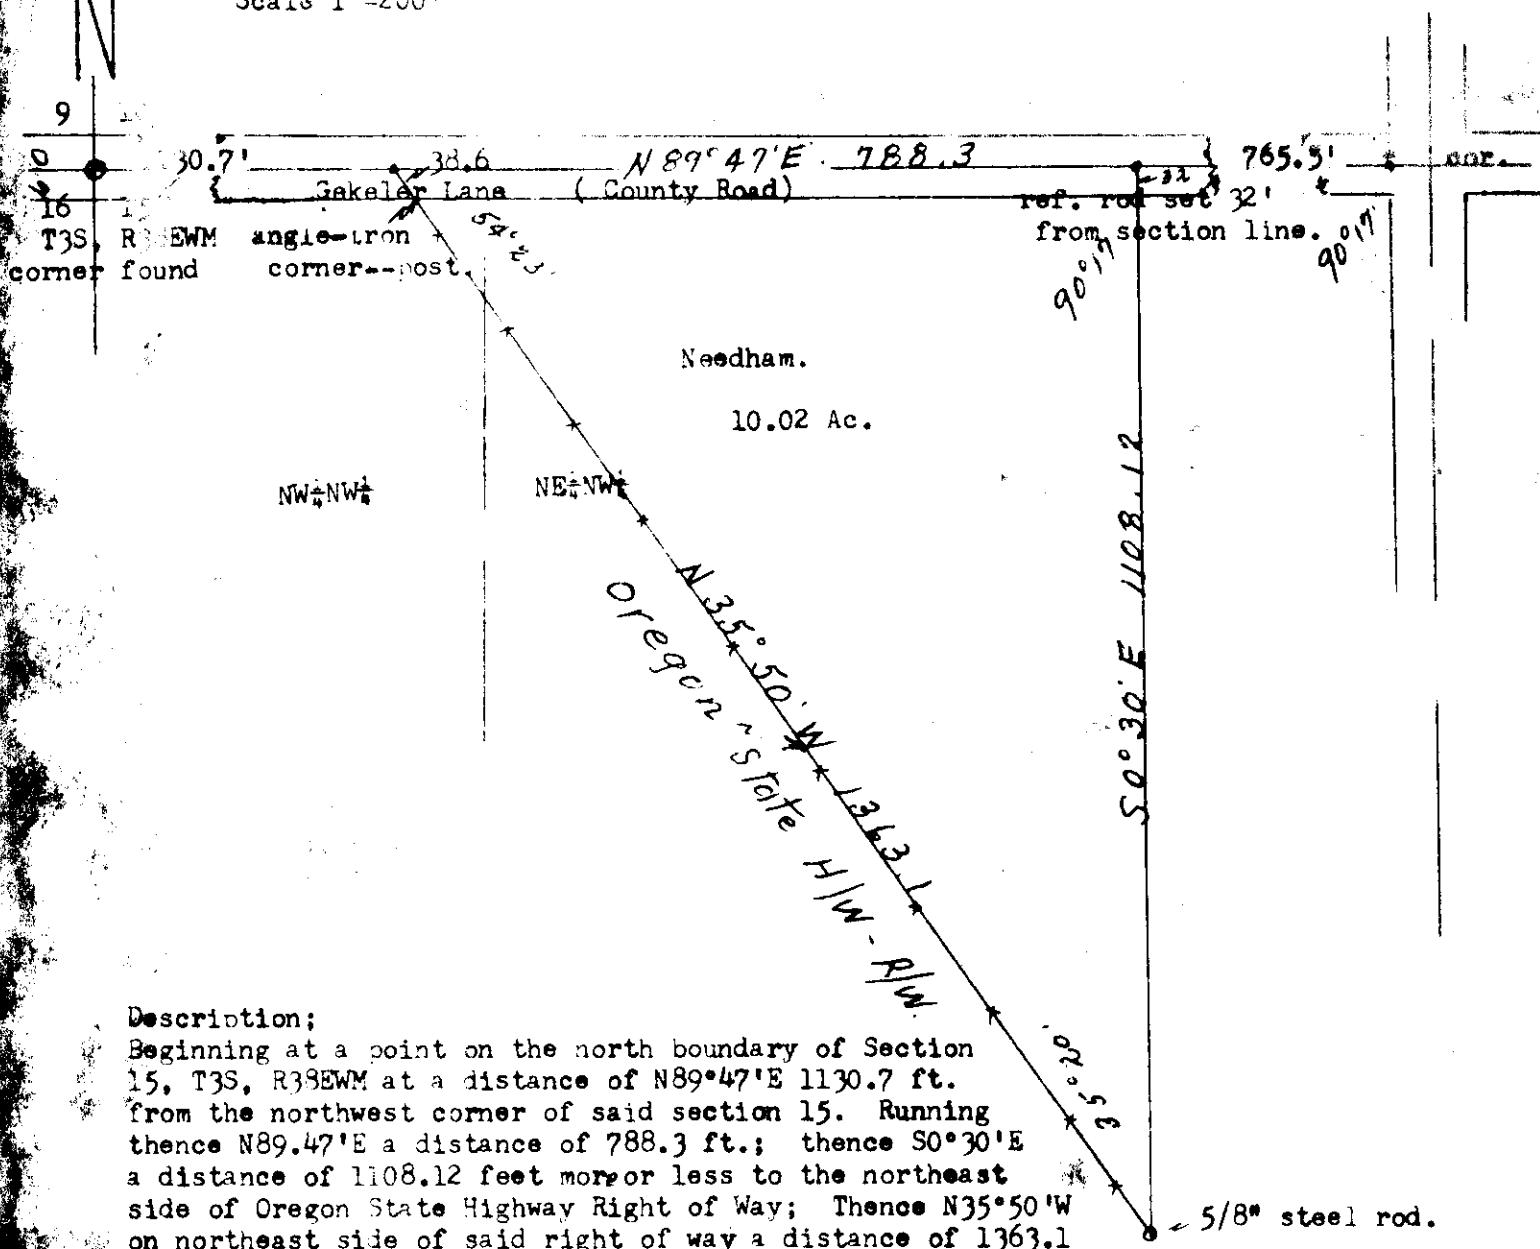

Description:

Beginning at a point on the north boundary of Section 15, T3S, R38EWM at a distance of N89°47'E 1130.7 ft. from the northwest corner of said section 15. Running thence N89.47'E a distance of 788.3 ft.; thence S0°30'E a distance of 1108.12 feet more or less to the northeast side of Oregon State Highway Right of Way; Thence N35°50'W on northeast side of said right of way a distance of 1363.1 ft. to point of beginning.

Situate in the north one half of northwest quarter of
Section 15, T3S, R3EWM and containing 10.02 acres more or less.

