


Larry Starr
Summerville, Oregon

June 12, 1971

Scale 1"=200'

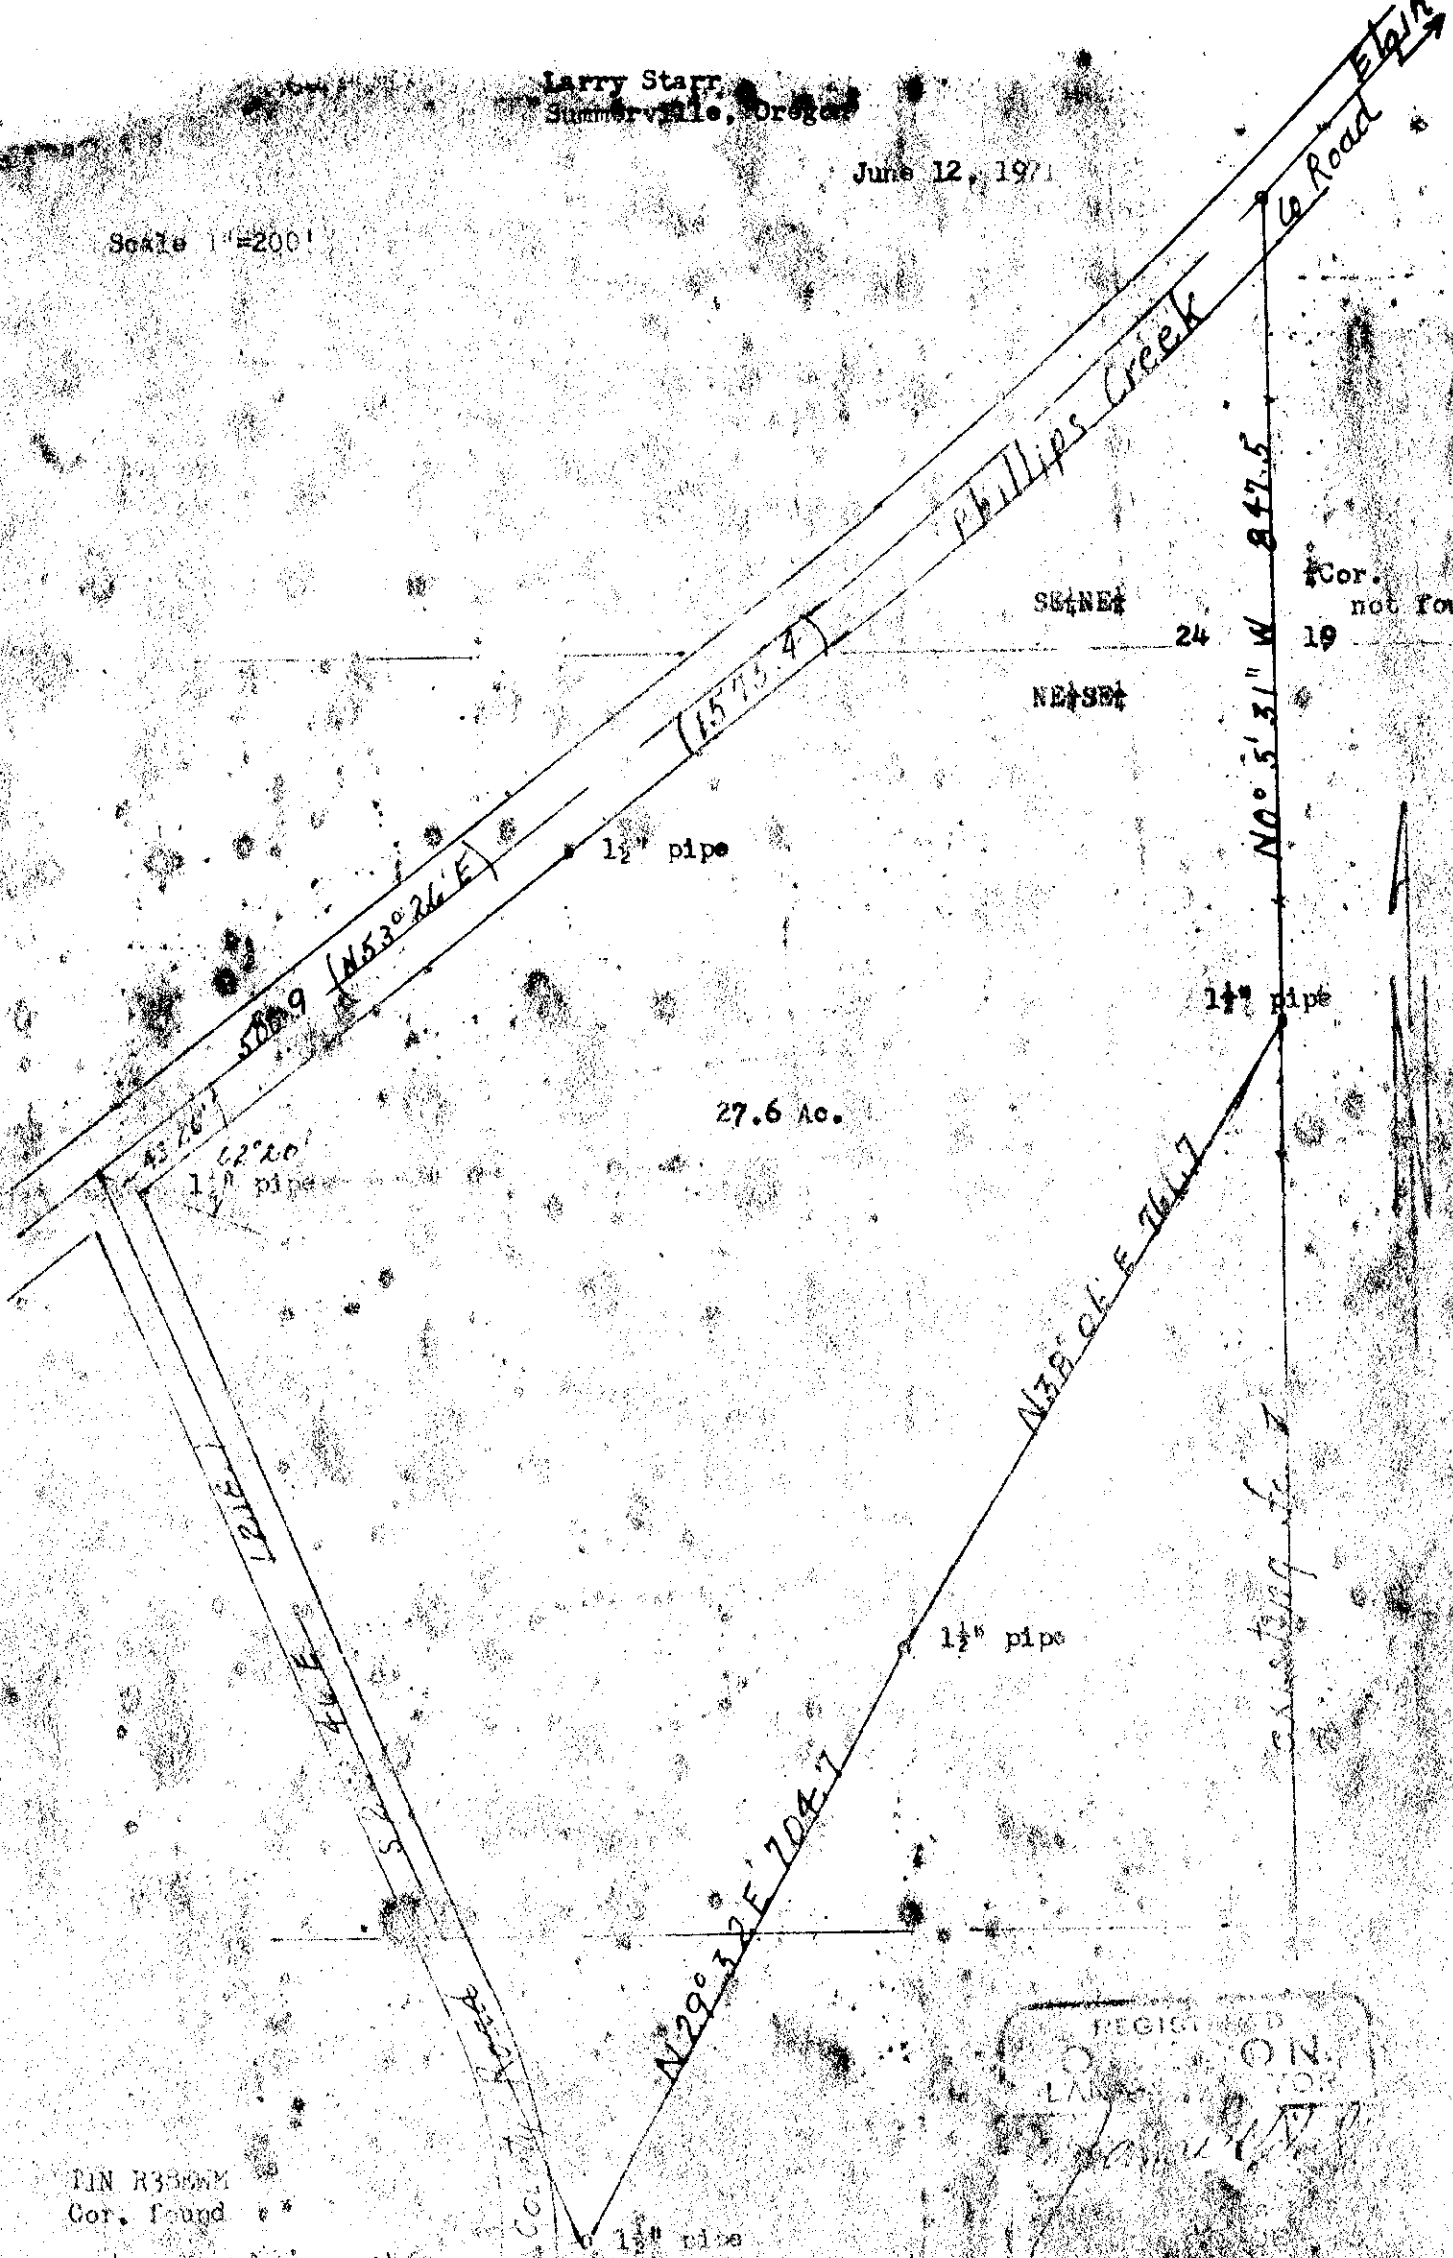

TIN R386MM
Cor. found

23

N77°46'16"

26

25

REGISTERED
LARRY STARR
SUMMERVILLE, OREGON

78-1971