


Clifford Needham
Rt. #1 Box 1719
La Grande, Oregon

May 7, 1971

initial point

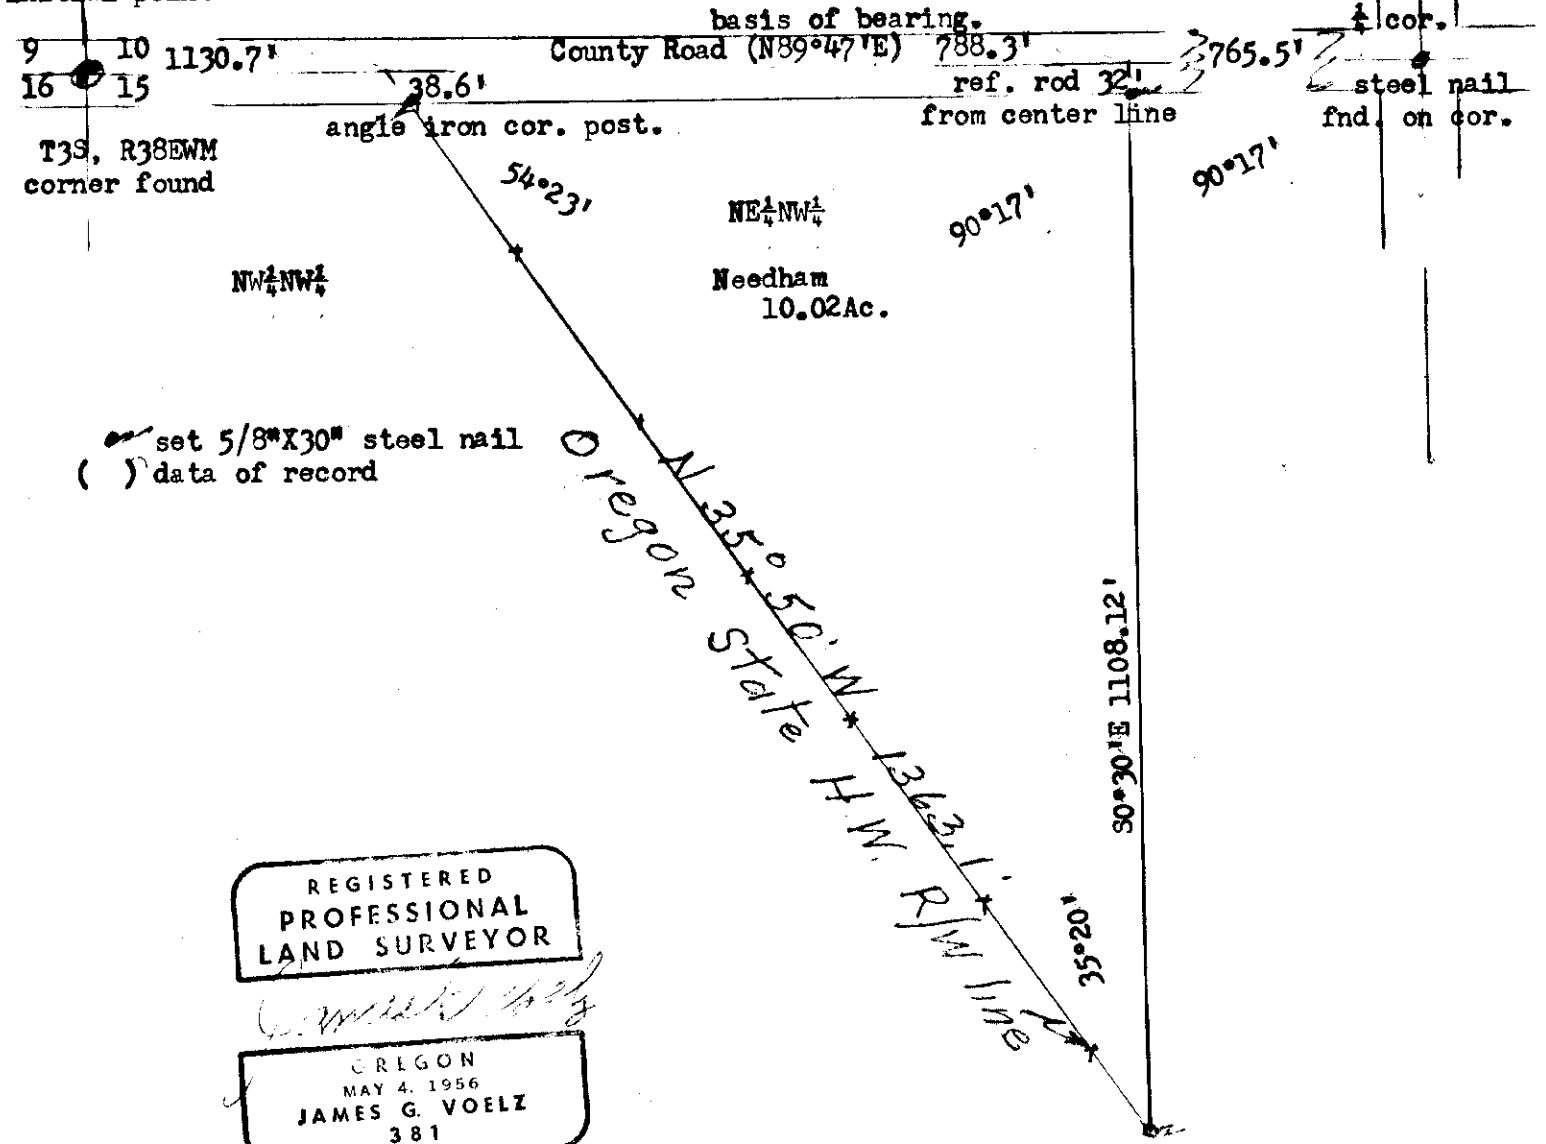

REGISTERED
PROFESSIONAL
LAND SURVEYOR

James G. Voelz

OREGON
MAY 4, 1956
JAMES G. VOELZ
381

78-1971A

78-71-A