


Lester Realty  
909 Main  
La Grande, Oregon

Nov. 27, 1971

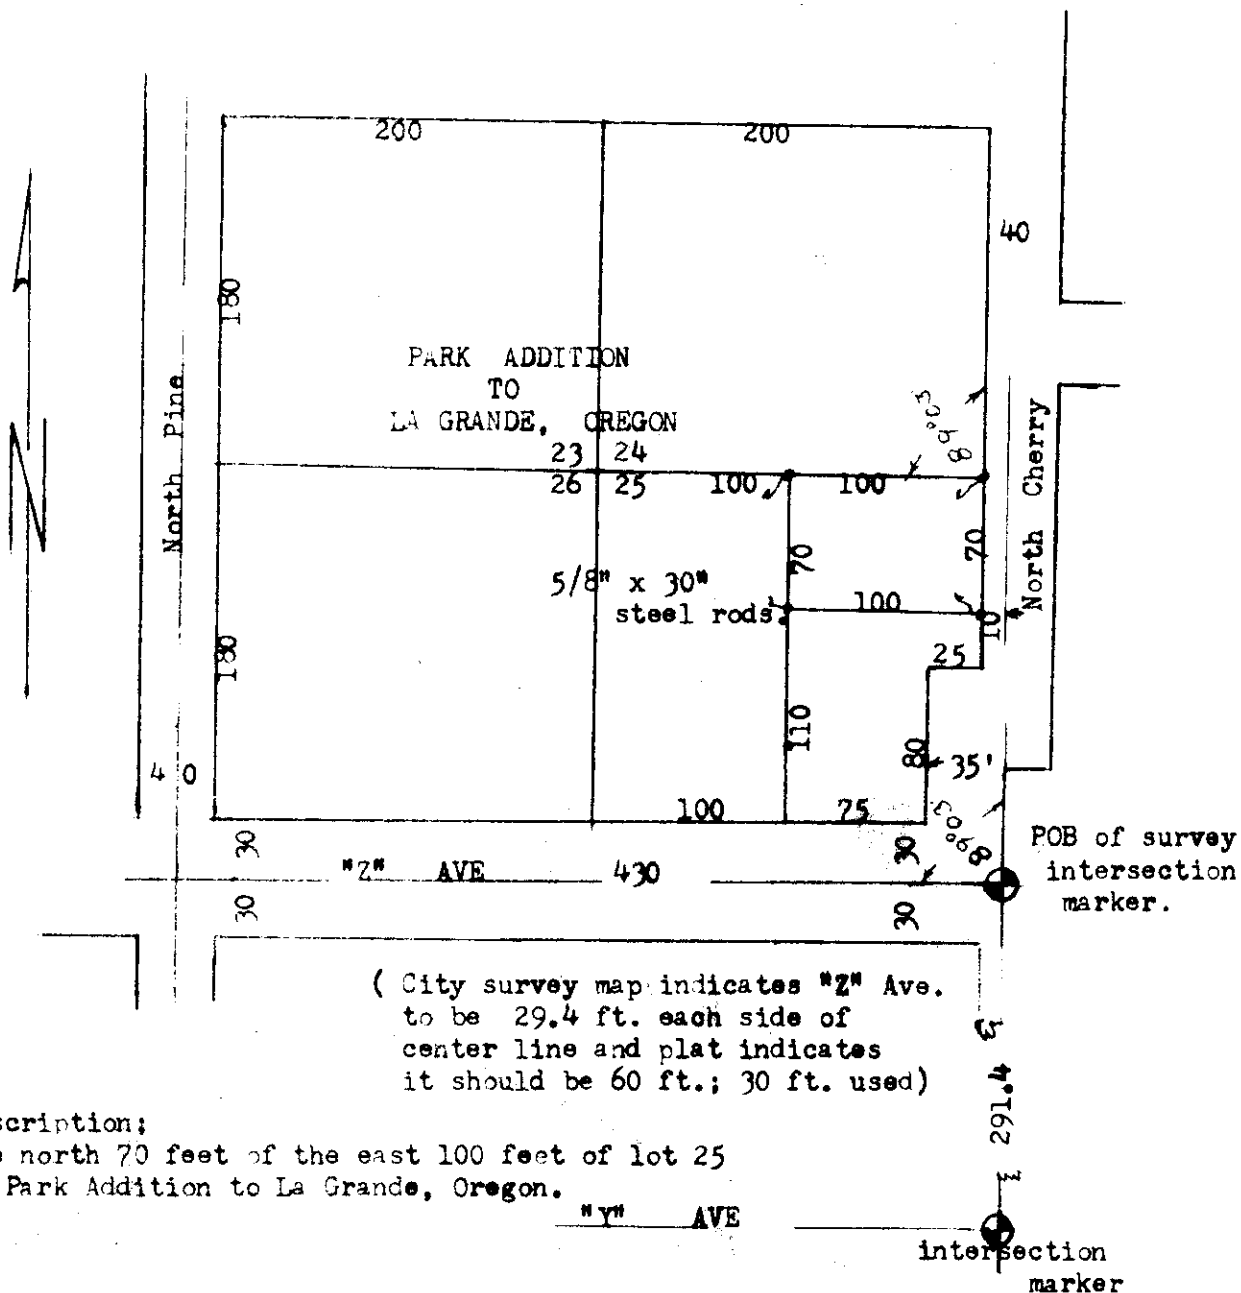

description:

The north 70 feet of the east 100 feet of lot 25  
of Park Addition to La Grande, Oregon.

REGISTERED  
OREGON  
LAND SURVEYOR

*James G. Voelz*

MAY 4, 1956  
JAMES G. VOELZ  
381

82-1971  
82-71

new