
P.J. Wright 2100 "H" Avenue La Grande, Oregon

Nov. 1 1971

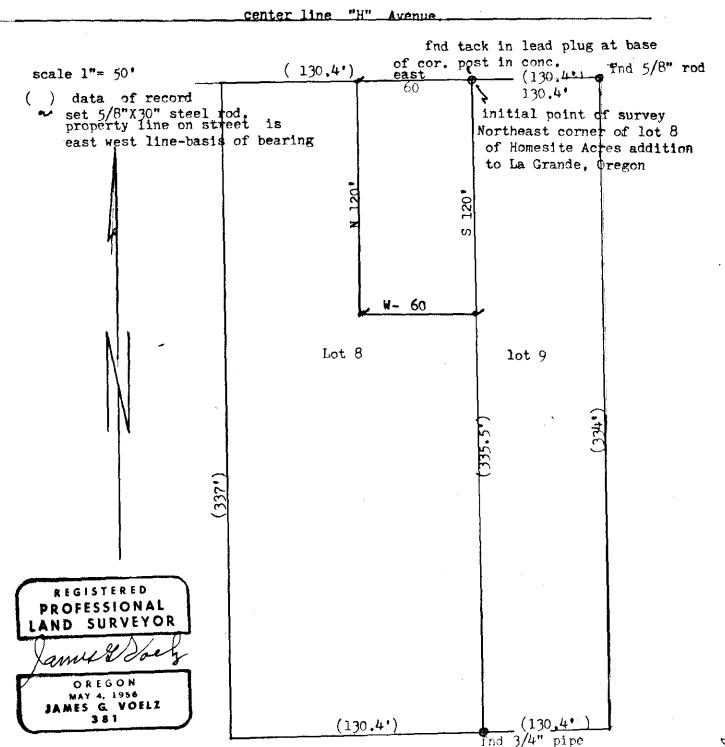

6-2