

Nov. 12, 1971

Jct. of east - west and
north - south fc. Cor.

T1N., R39EWM.

34 35
3 2

Description; Beginning at a point on the east boundary of section 3, T1N, R39EWM at a distance of S0°21'W ; 1884.4 ft.; from the northeast corner of said section.

Th. east 136.8 ft.;

Th. S0°21'W 190 ft.;

Th. S62°16'W 600 ft.;

Th. N9°51'W 389.6 ft.;


Th. N30°02'W 98.6 ft.;

Th. East 418.2 ft. to point of beginning.

SITUATED in Section 3, T1N, R39EWM and NW 1/4 SW 1/4 of Section 3, T1N, R39EWM containing 4.39 Ac. more or less.

Scale - 1" = 200'

(G10)

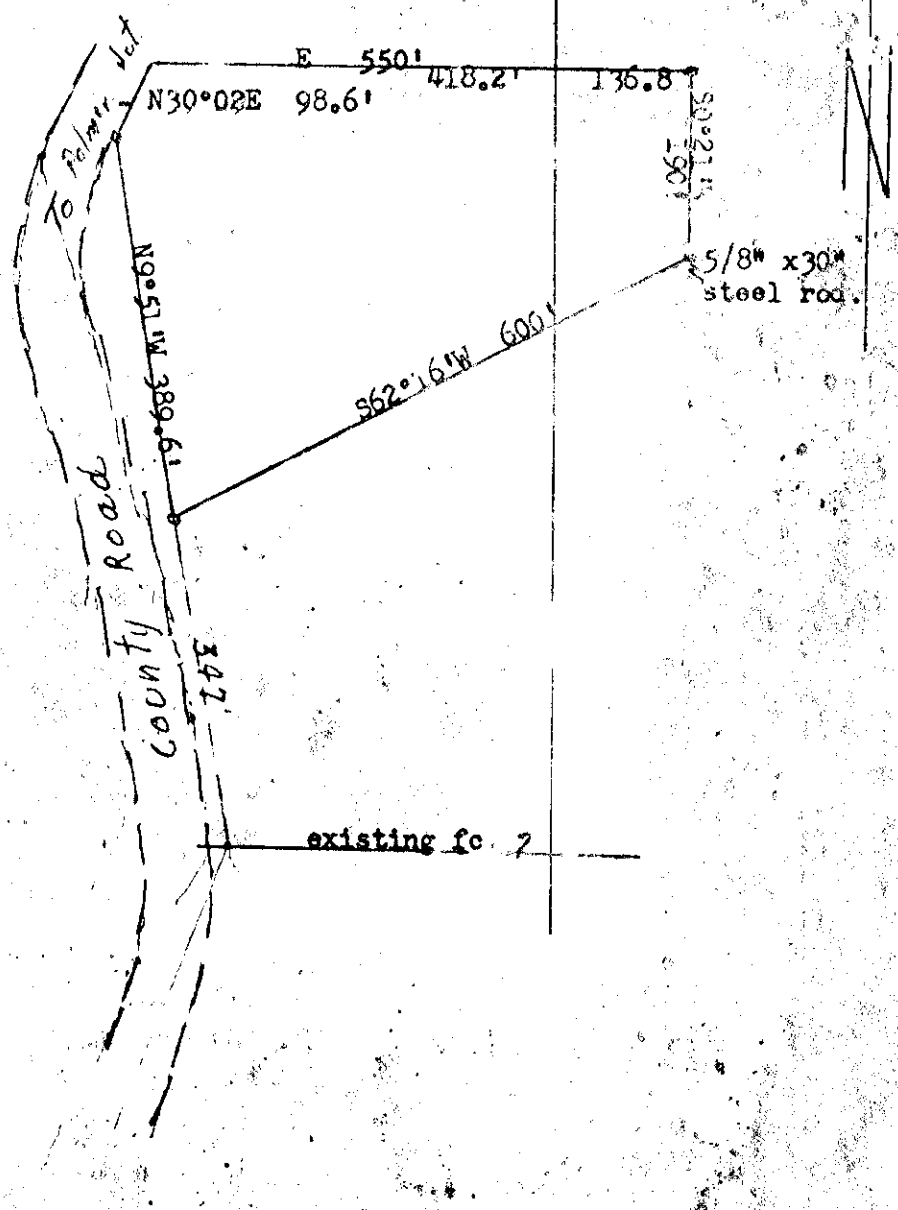

REGISTERED
OREGON
LAND SURVEYOR

James G. Voeltz

MAY 4, 1958
JAMES G. VOELTZ
331

87-1971