


Robert C. Green
 Rt. #2, Box 2530
 La Grande, Oregon

Oct. 22, 1971

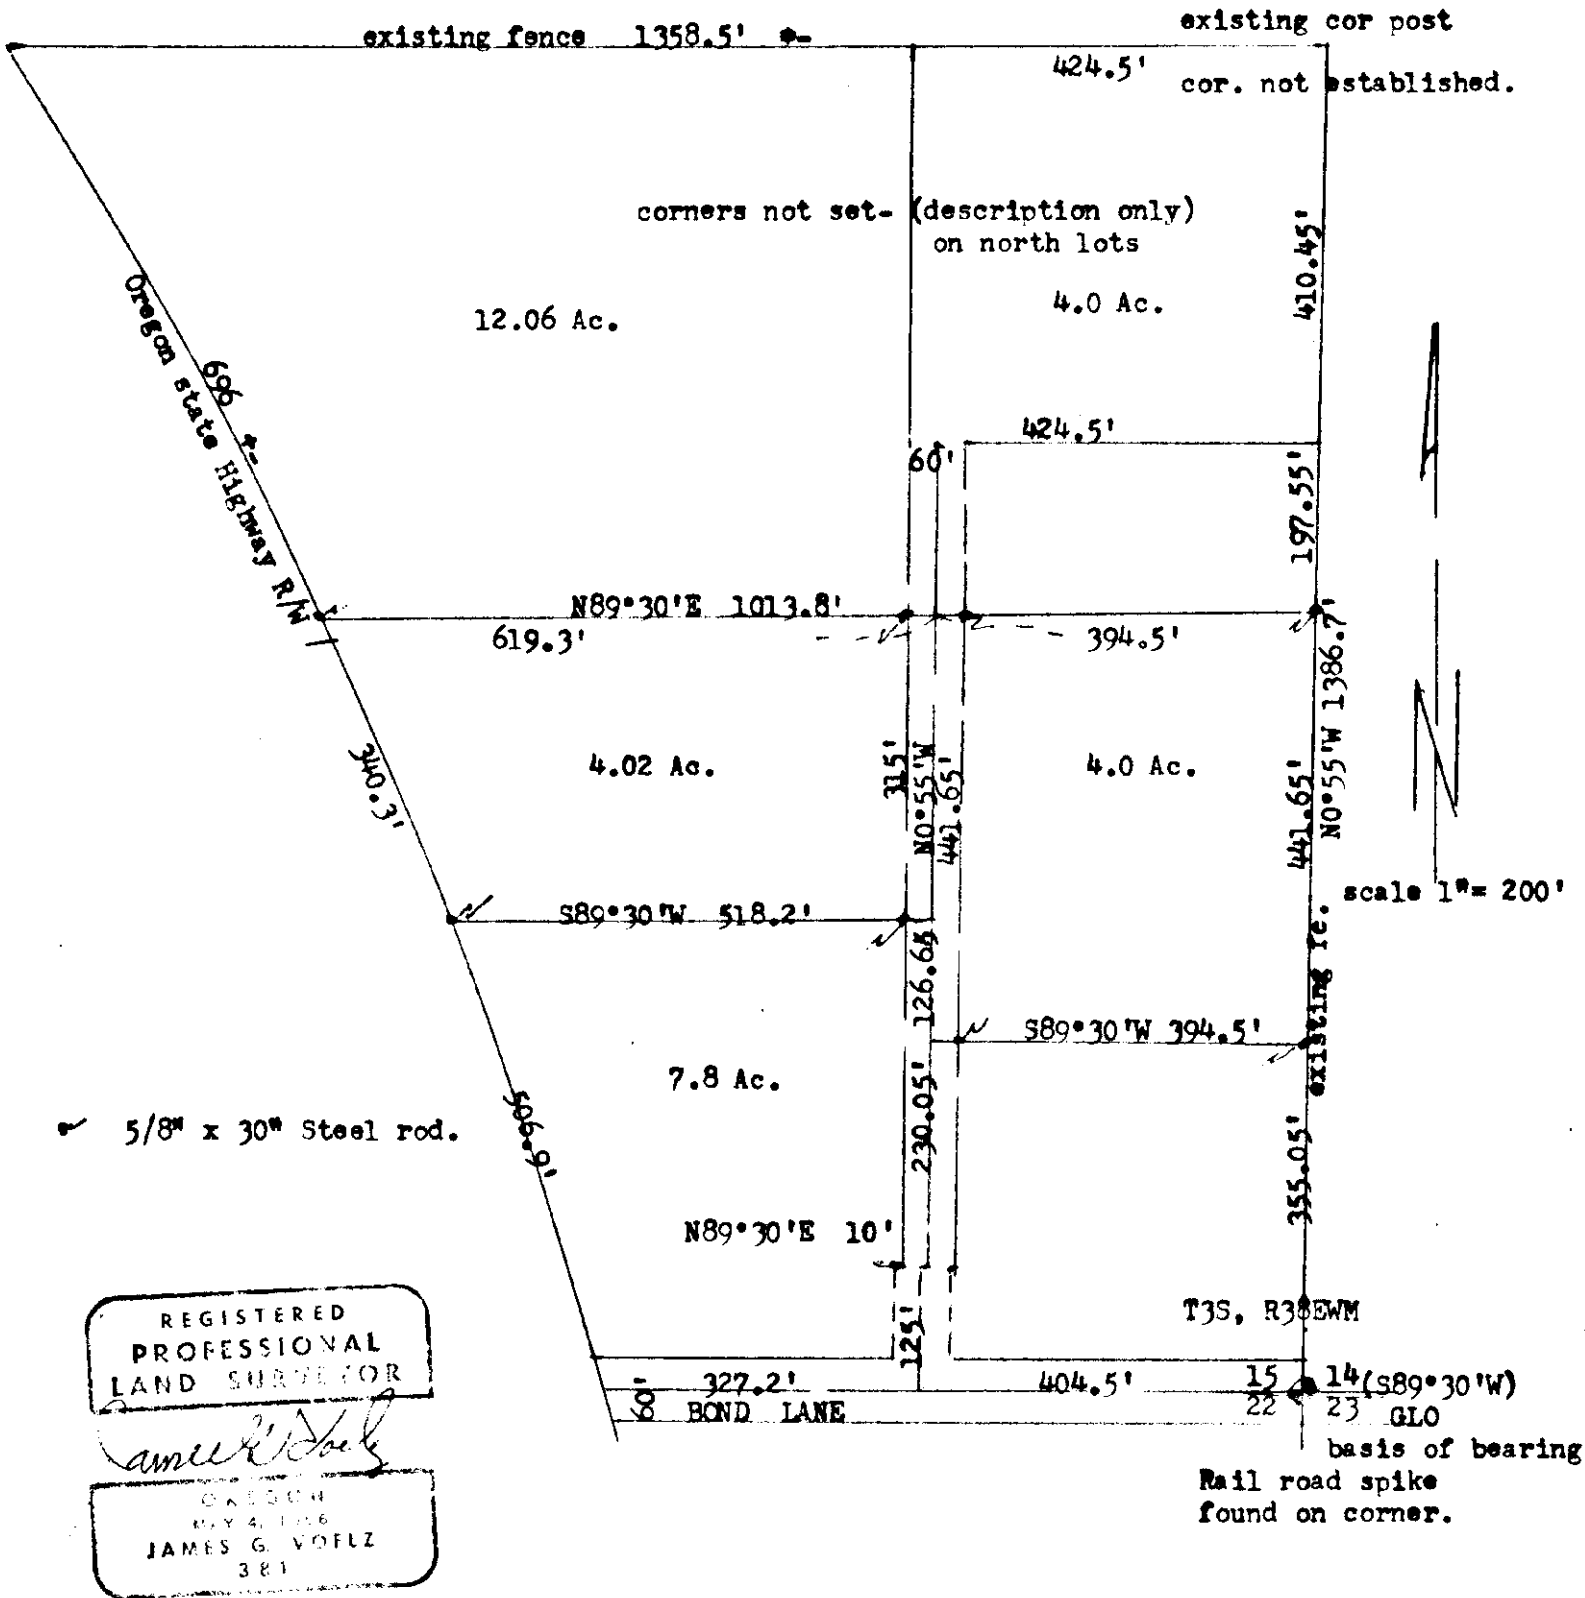

89-1971