


Grande Ronde Hospital
La Grande, Oregon

May 11, 1971

Scale 1" = 100'

- set 5/8" X 30" steel rod
- () data of record
- o corners found in place.

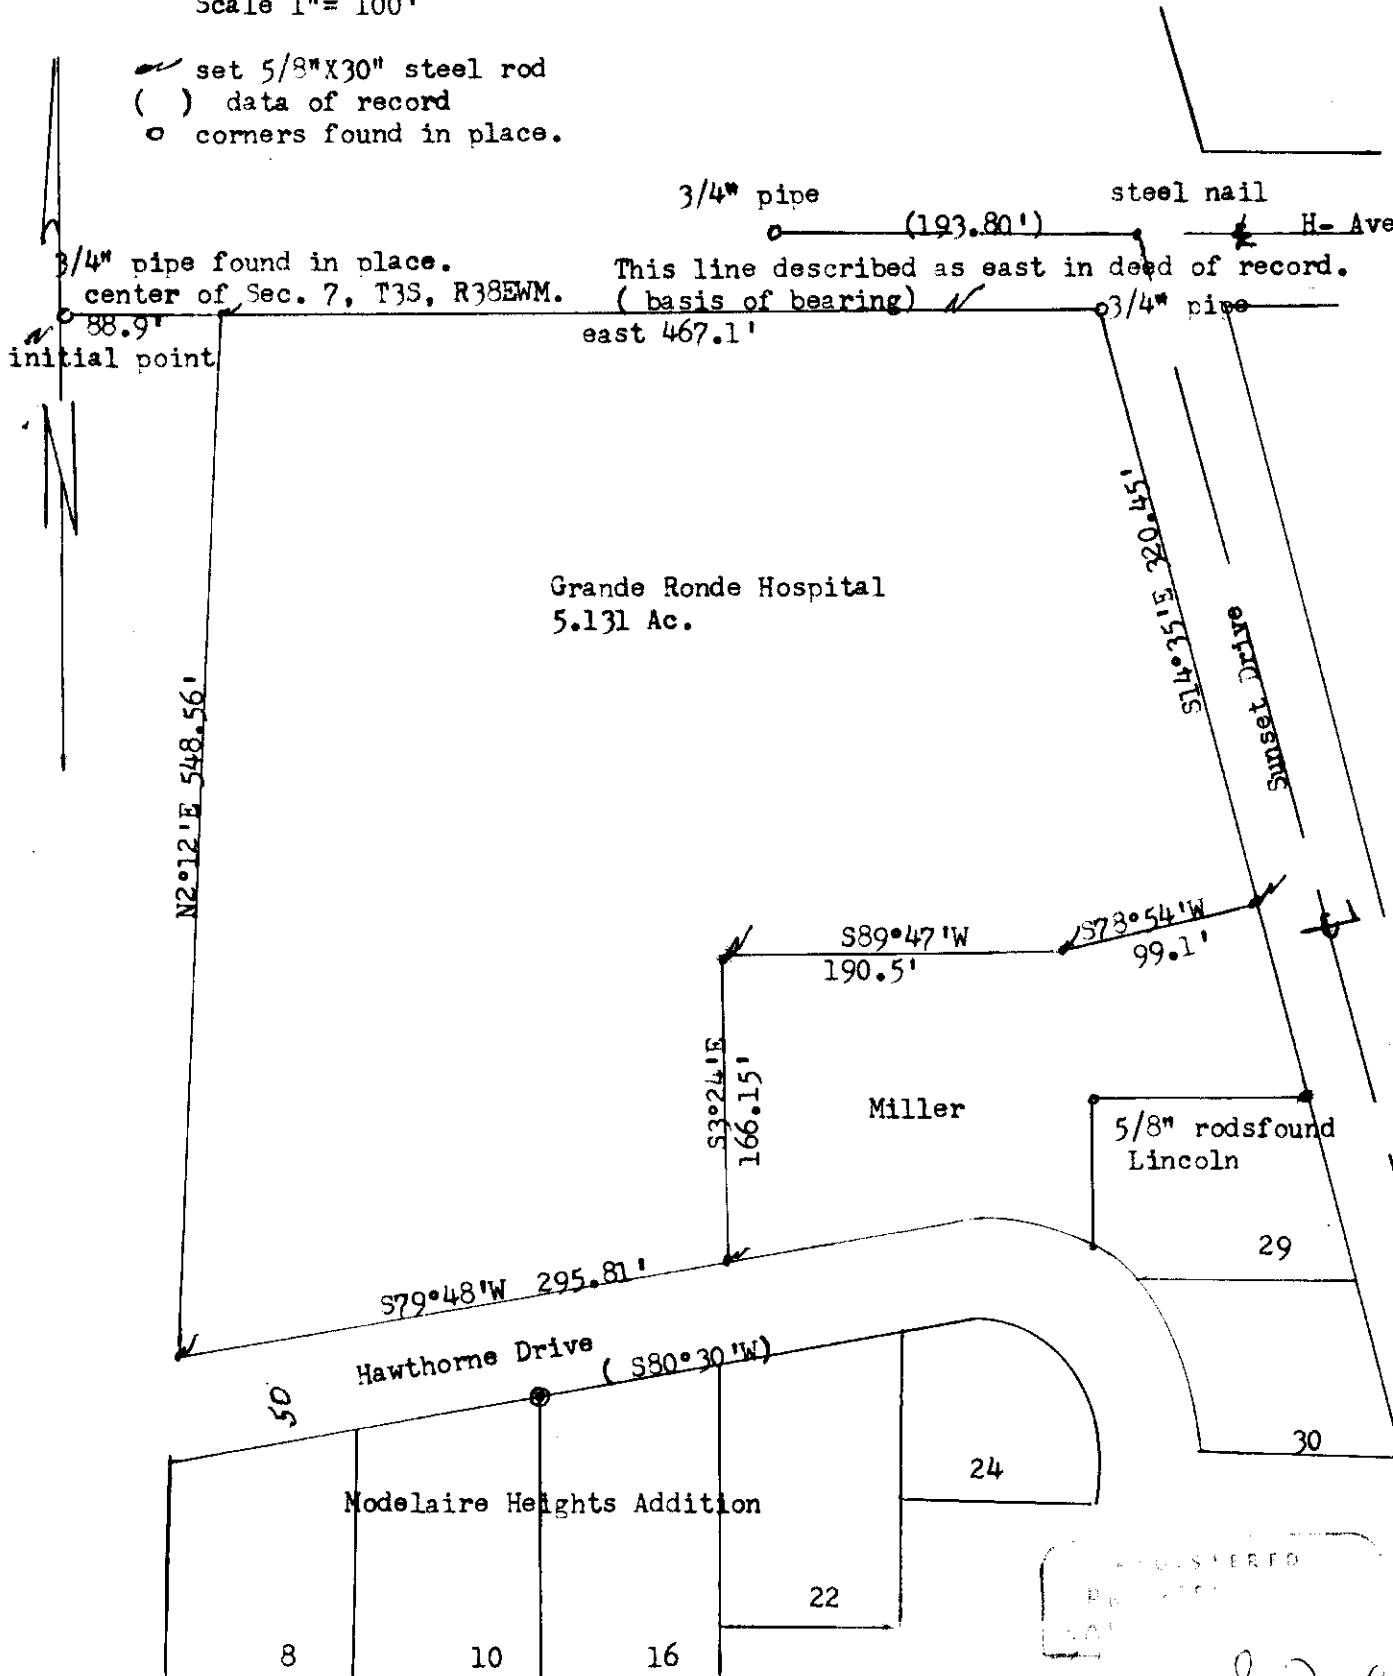

REGISTERED
PLAT
1971
MAY 11 1971
Frank G. [Signature]