



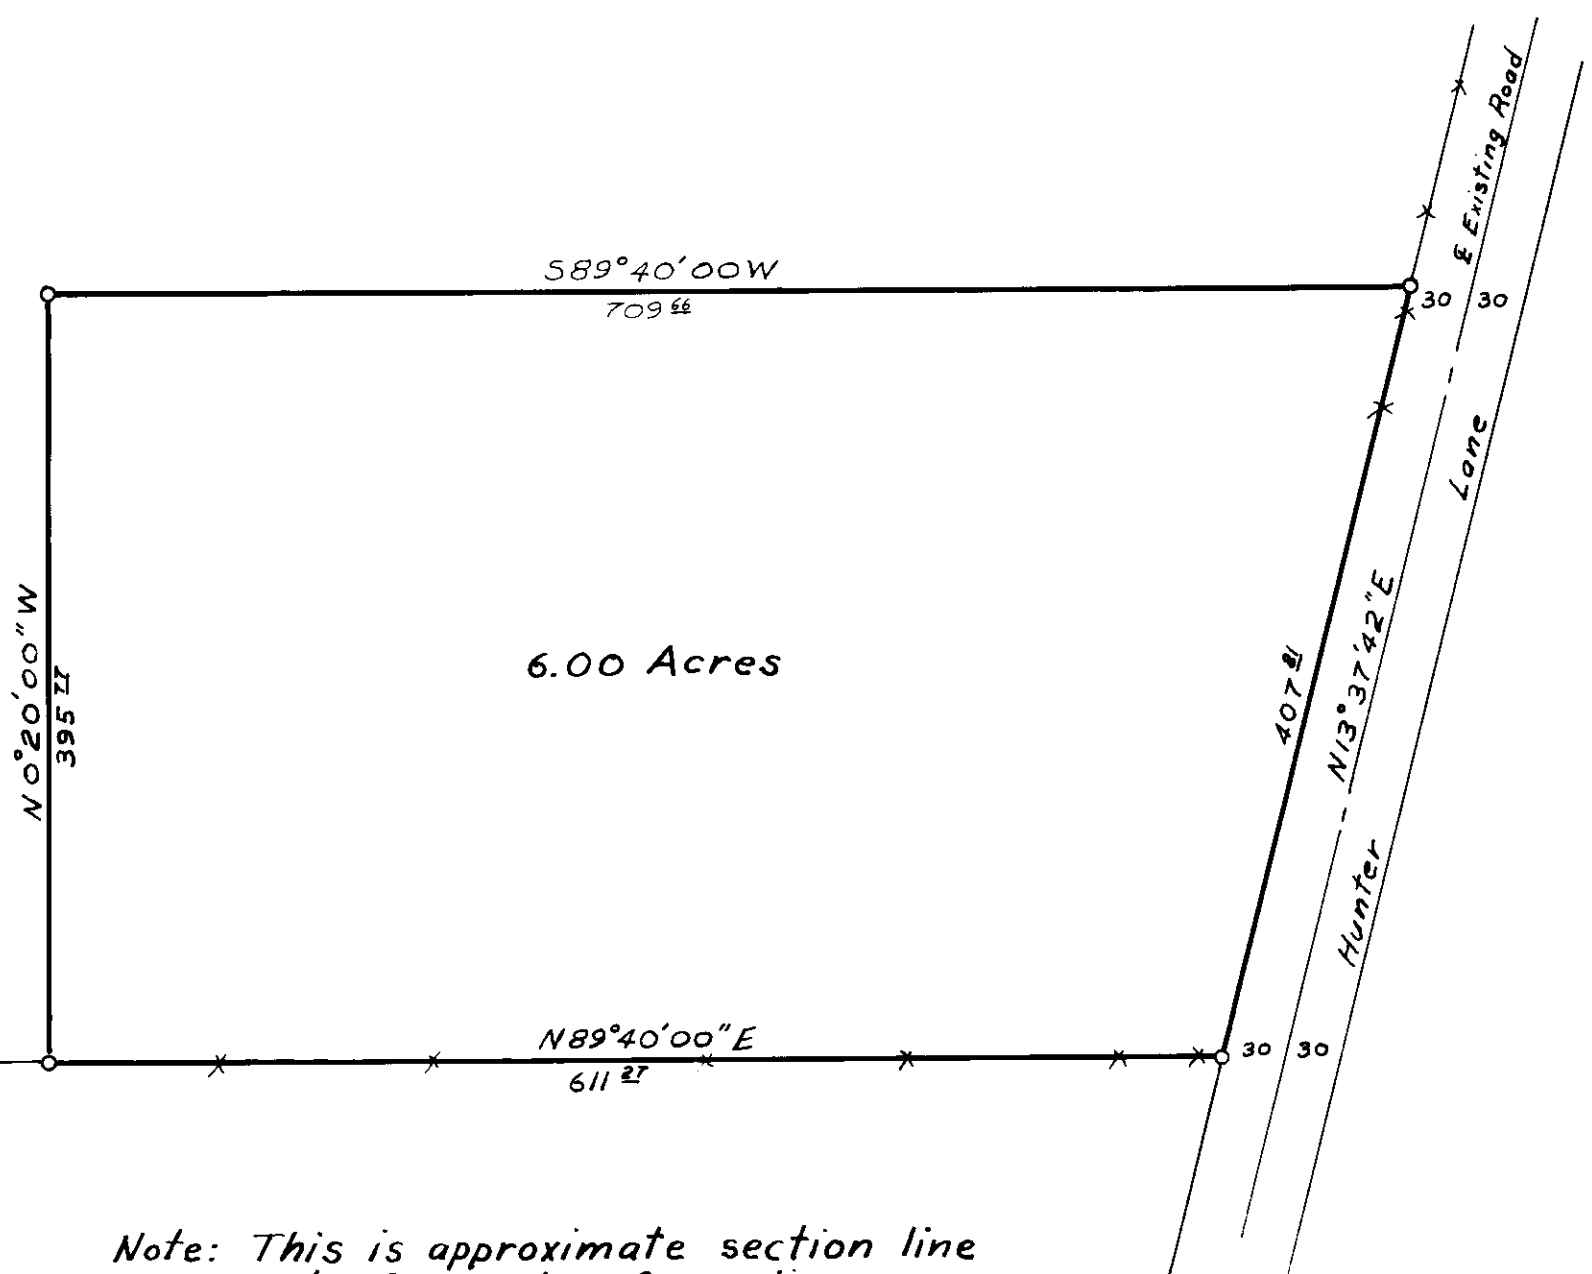

BASIS OF BEARING
Solar Observations

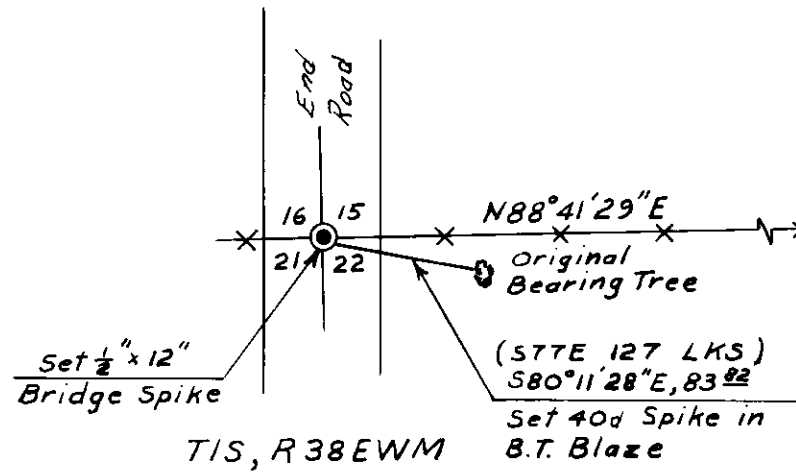

Note: This is approximate section line only. Pins set in fence line indicate line only. South line of this parcel is to lay on section line.

LEGEND

- Set $\frac{5}{8}$ " x 30" iron pin with plastic cap marked BGF Survey Mk.
- () Record bearing & district
- *—* Existing Fence Line

REGISTERED
PROFESSIONAL
LAND SURVEYOR

Duane I. Griffith

OREGON
JULY 10, 1964
DUANE I. GRIFFITH
644

BAGETT-GRIFFITH-FERGUSON		
La Grande, Oregon		
Map of Survey		
Parcel in the SE $\frac{1}{4}$; SW $\frac{1}{4}$		
Section 15, T1S R38 EWM		
UNION COUNTY, OREGON		
SURVEYED FOR	Robert T. Opie	by DIG
DESIGNED FOR		by
Scale: 1" = 100'	Drawn by LET	Mar 1972