


California Pacific Utilities  
La Grande, Oregon

Scale 1" = 100'

March 17, 1972

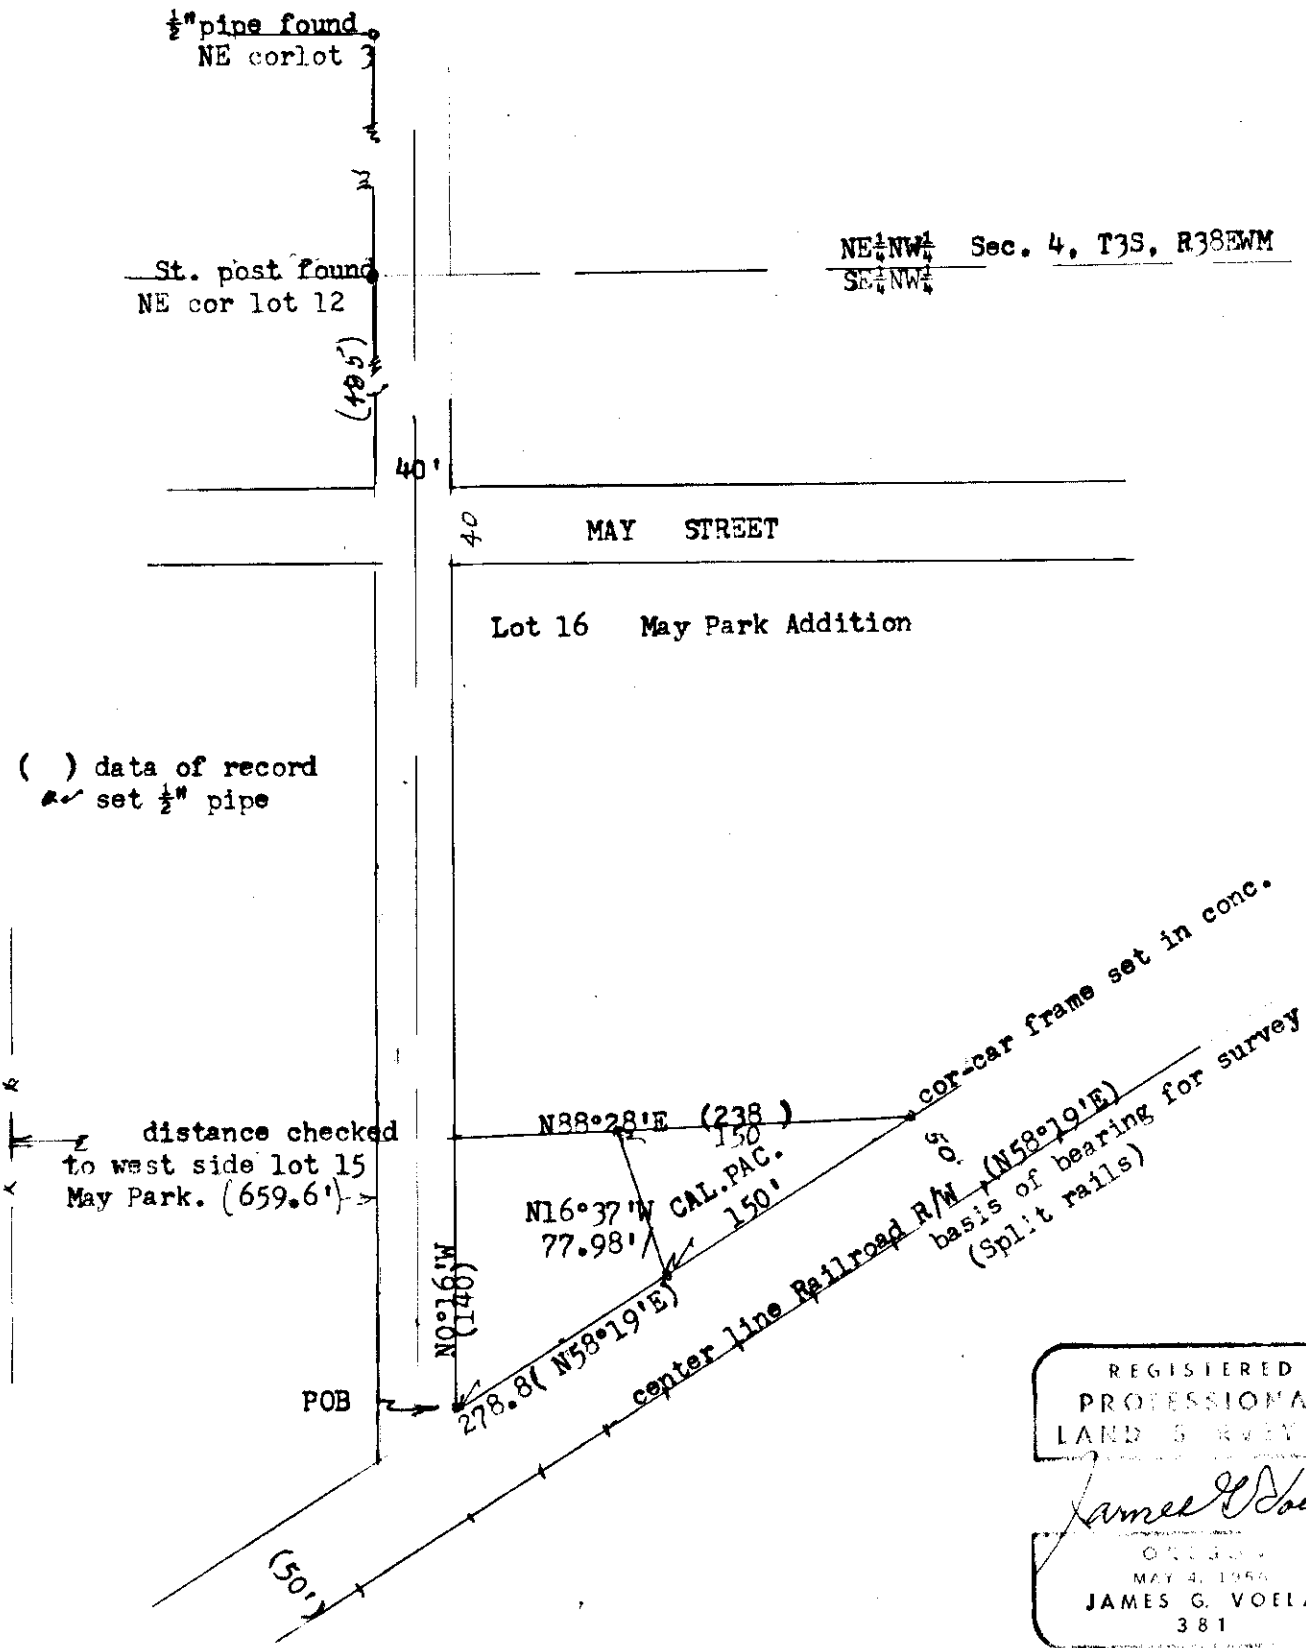

REGISTERED  
 PROFESSIONAL  
 LAND SURVEYOR  
*James G. Voelz*  
 OREGON  
 MAY 4, 1956  
 JAMES G. VOELZ  
 381

3-72