L.M Shelton
Rt. 2 Box 185
La Grande, Oregon

Jan 24, 1972

Scale 1"= 200'

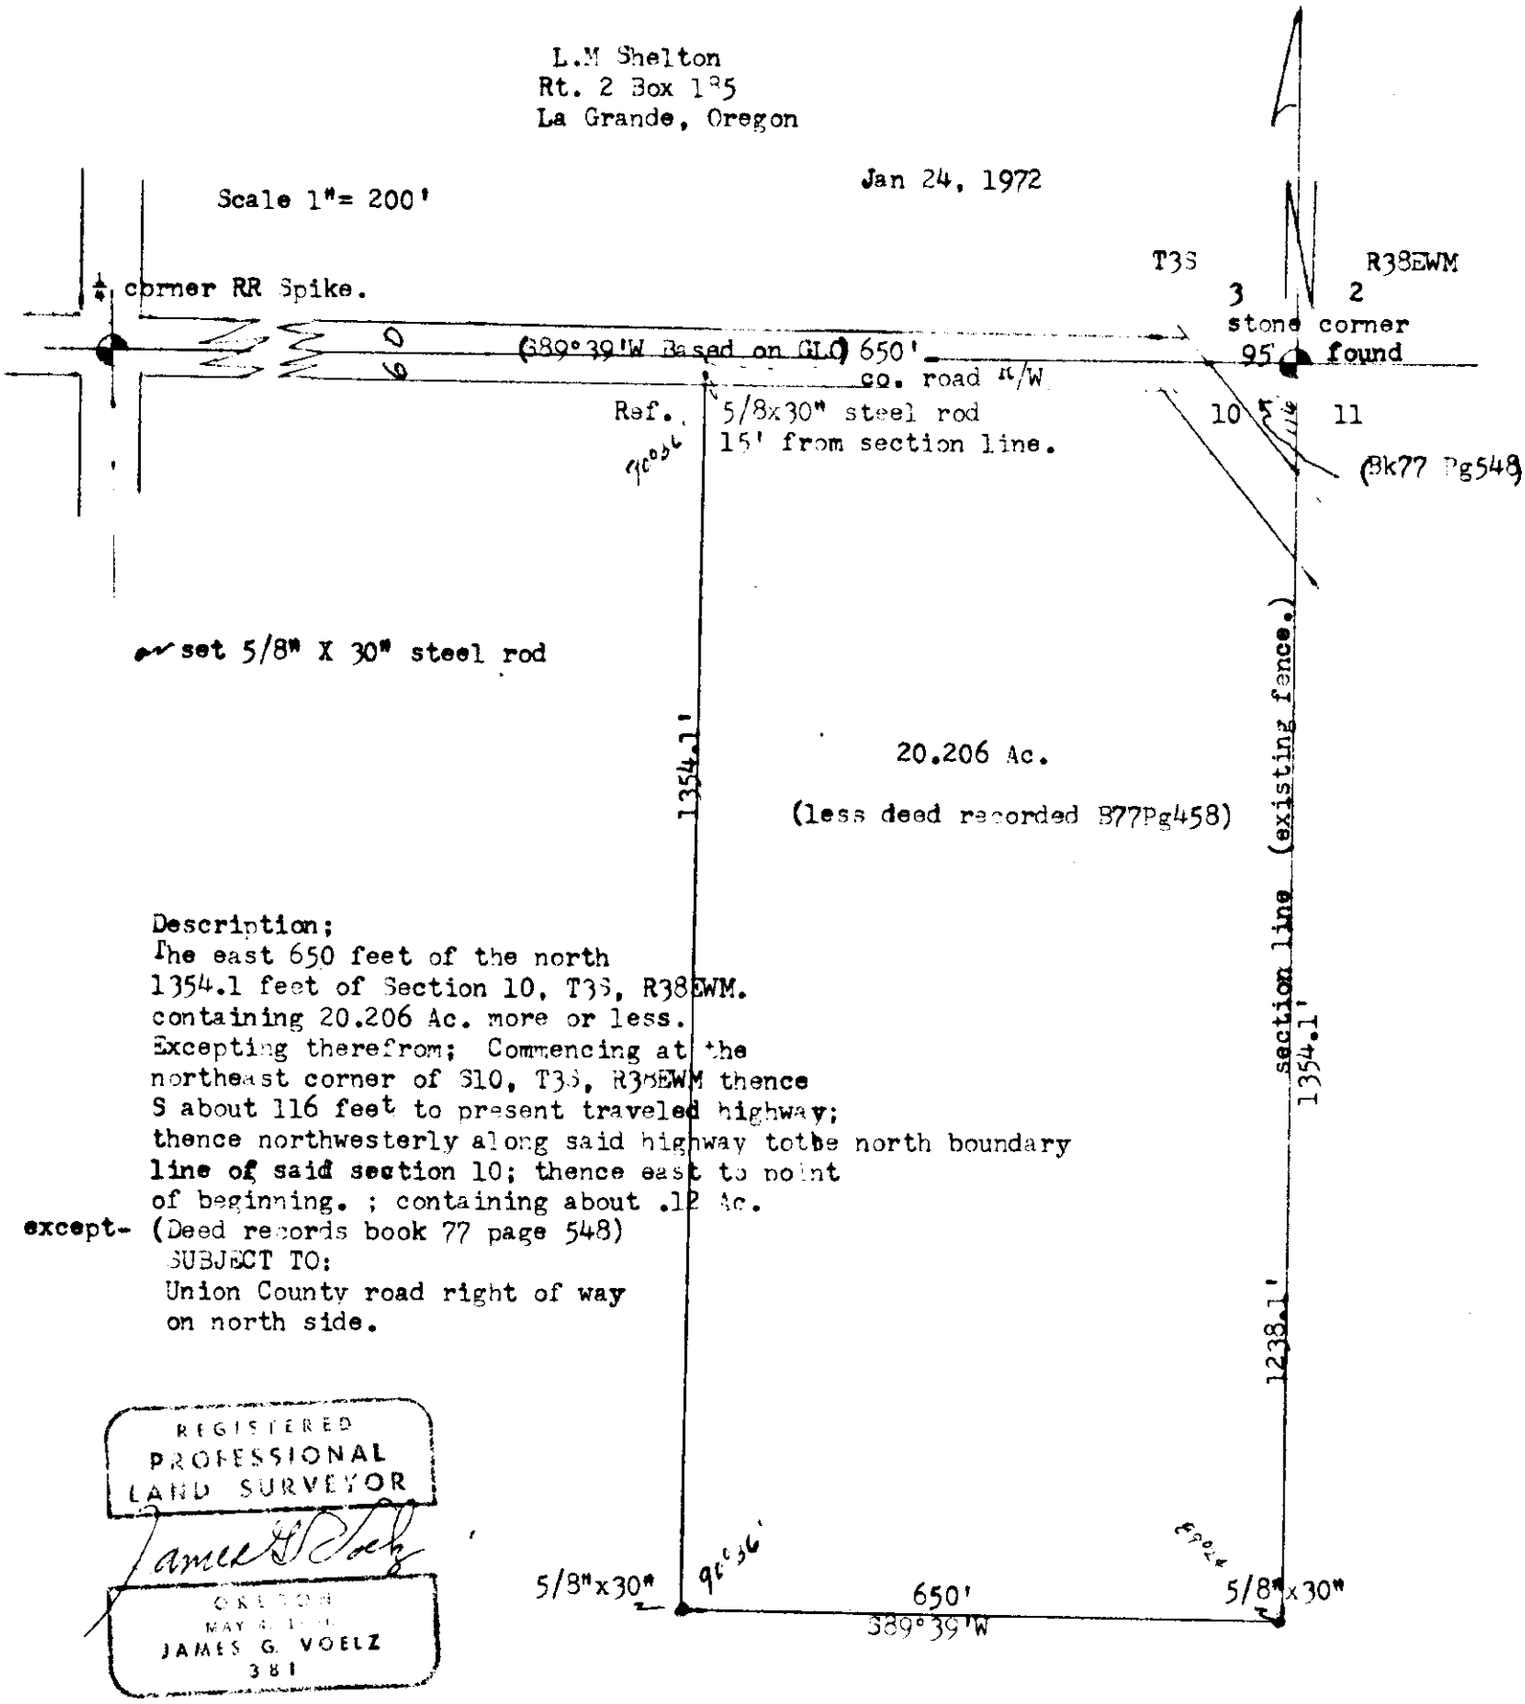

Description;
The east 650 feet of the north 1354.1 feet of Section 10, T3S, R38EWM. containing 20.206 Ac. more or less.
Excepting therefrom; Commencing at the northeast corner of S10, T3S, R38EWM thence S about 116 feet to present traveled highway; thence northwesterly along said highway tothe north boundary line of said section 10; thence east to point of beginning. ; containing about .12 Ac.
except- (Deed records book 77 page 548)
SUBJECT TO:
Union County road right of way on north side.

REGISTERED
PROFESSIONAL
LAND SURVEYOR
James G. Voelz
OREGON
MAY 6, 1968
JAMES G. VOELZ
381

9-72

9-1972