


Harold Beickel
 609 Y Ave.
 La Grande, Oregon

March 9, 1972

Scale 1" = 50'

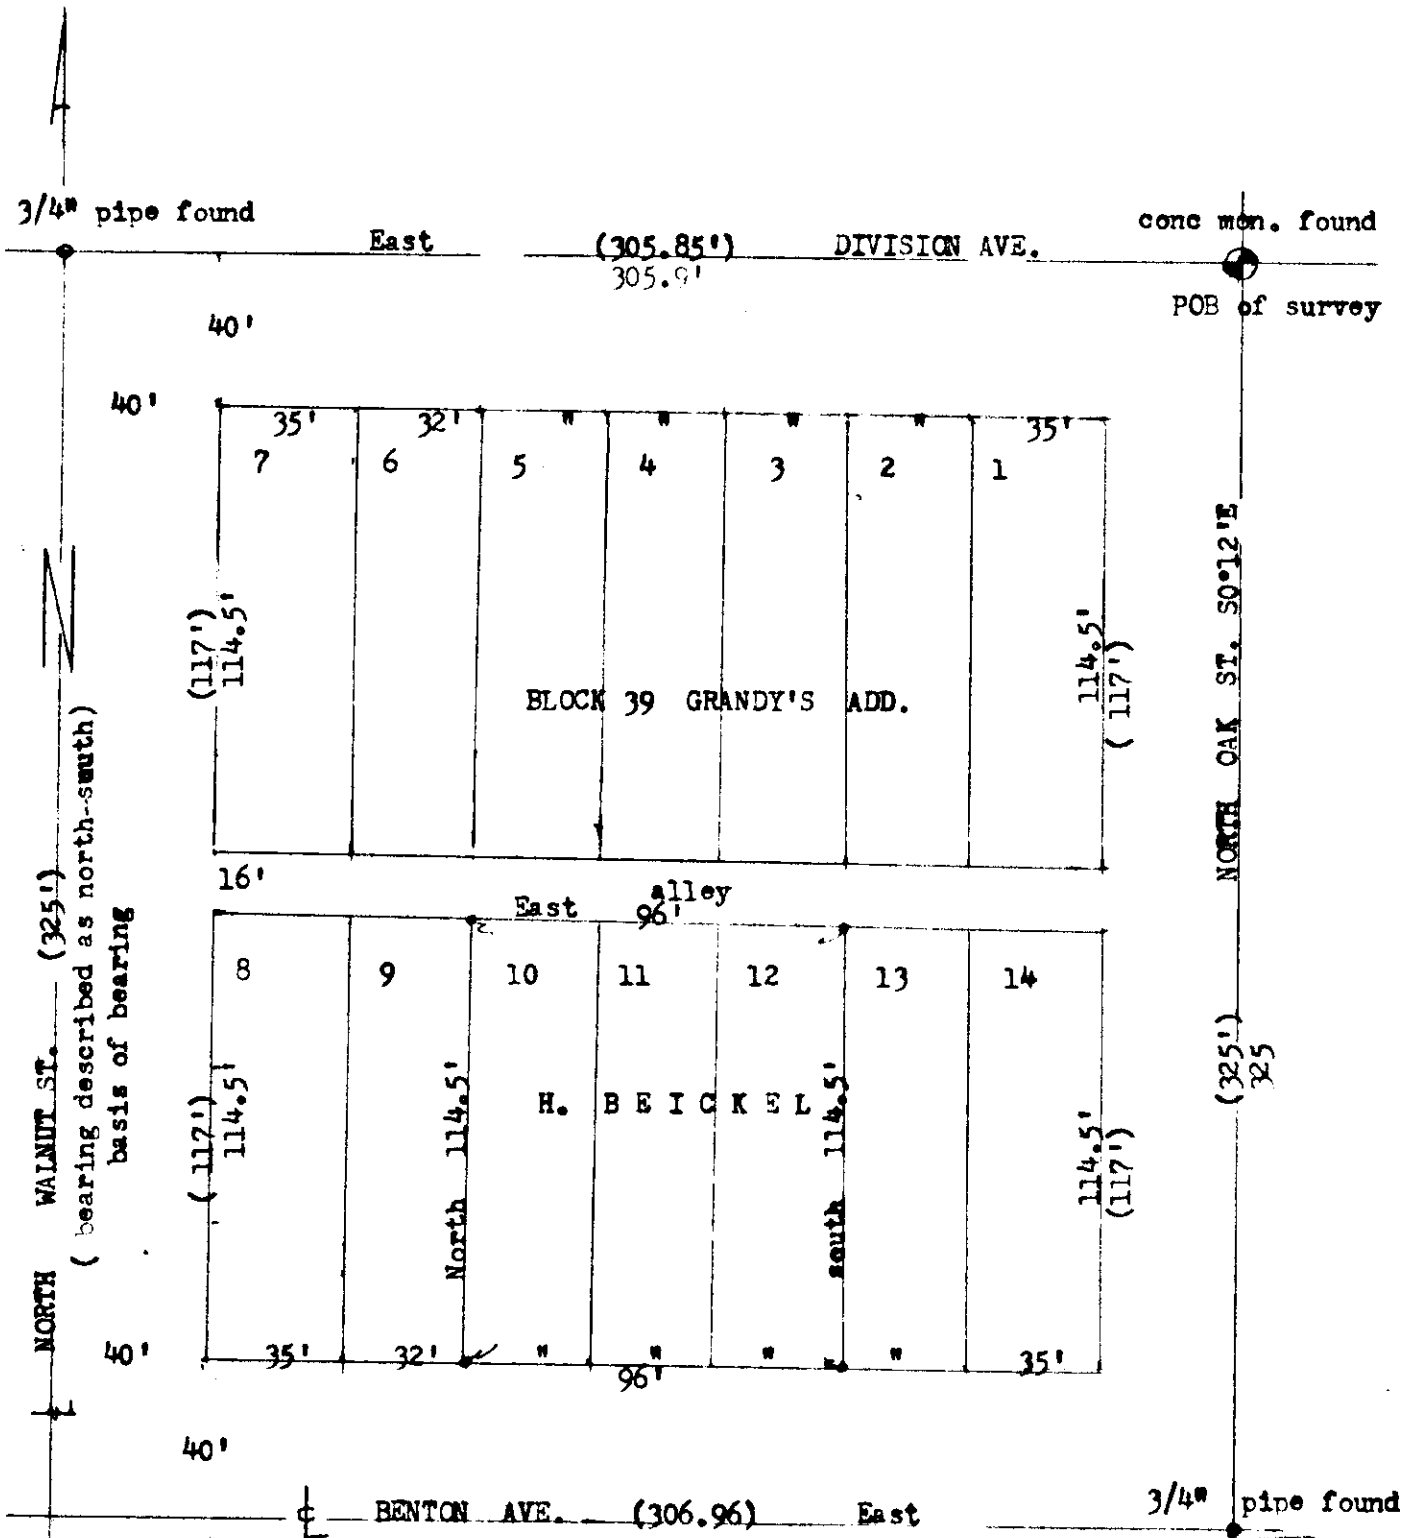

() data of record.
 or 5/8" X 30" steel rod. set.

REGISTERED
 PROFESSIONAL
 LAND SURVEYOR

James G. Voelz

OREGON
 MAY 2, 1965
 JAMES G. VOELZ
 381

11-72

11-1972