


L. Glenn Arnold  
 503 "B" Ave.  
 La Grande, Oregon.

March 15, 1972

scale 1" = 20'

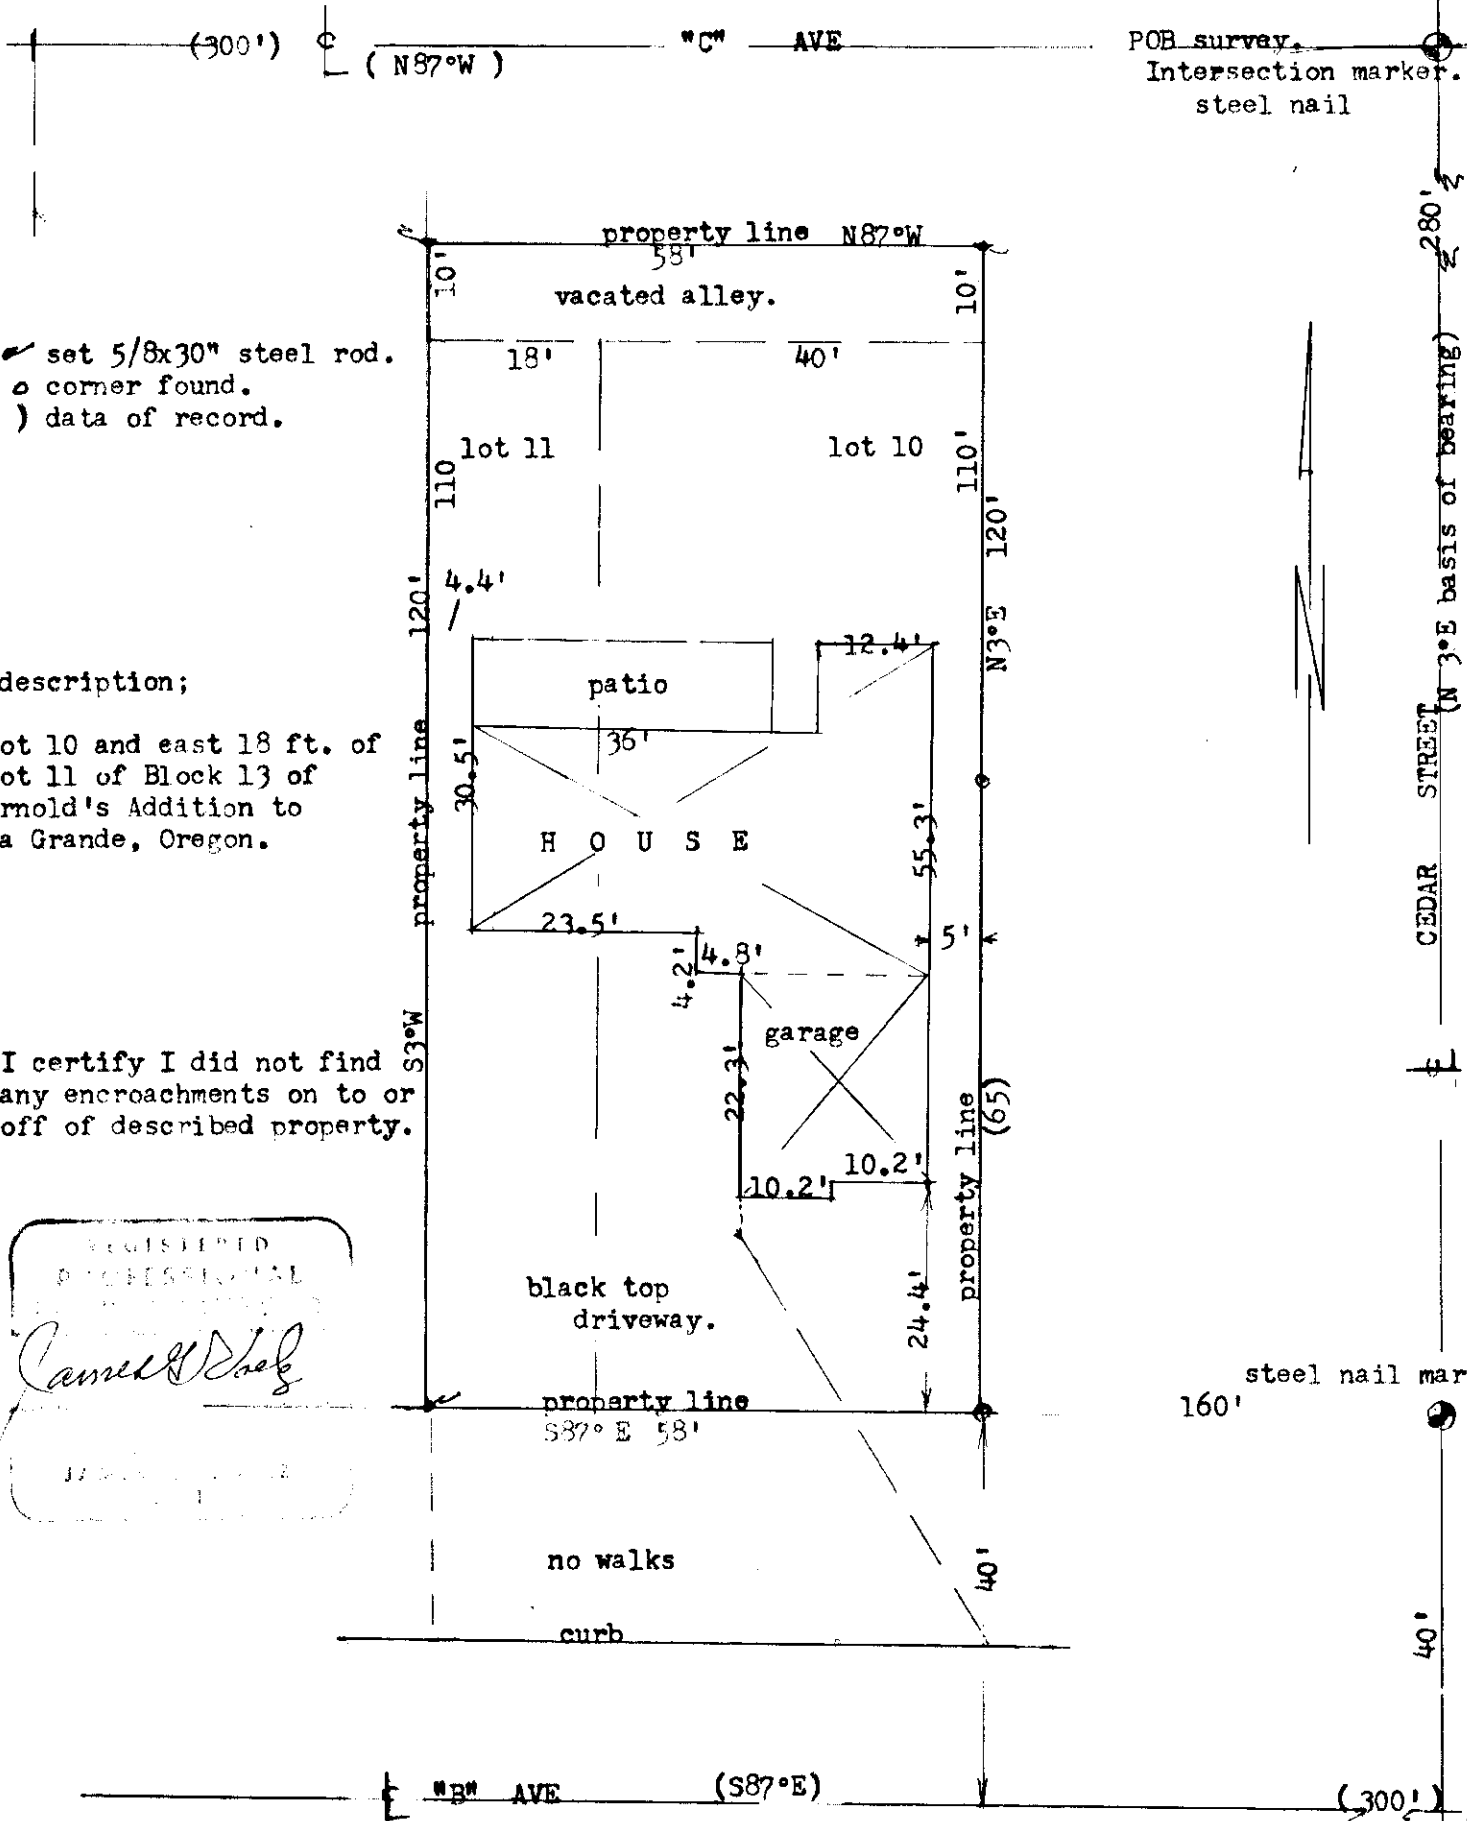

- ✓ set 5/8x30" steel rod.
- corner found.
- ( ) data of record.

**description;**

Lot 10 and east 18 ft. of lot 11 of Block 13 of Arnold's Addition to La Grande, Oregon.

I certify I did not find any encroachments on to or off of described property.

REGISTERED PROFESSIONAL  
*Camel Walsh*  
 1125 1/2

steel nail marker.  
 160'

CEDAR STREET (N 3°E basis of bearing) 280'

12-1972

12-72