


Herbert H. & Devonna Mackie  
Elgin, Oregon

scale 1" = 100'

March 20, 1972

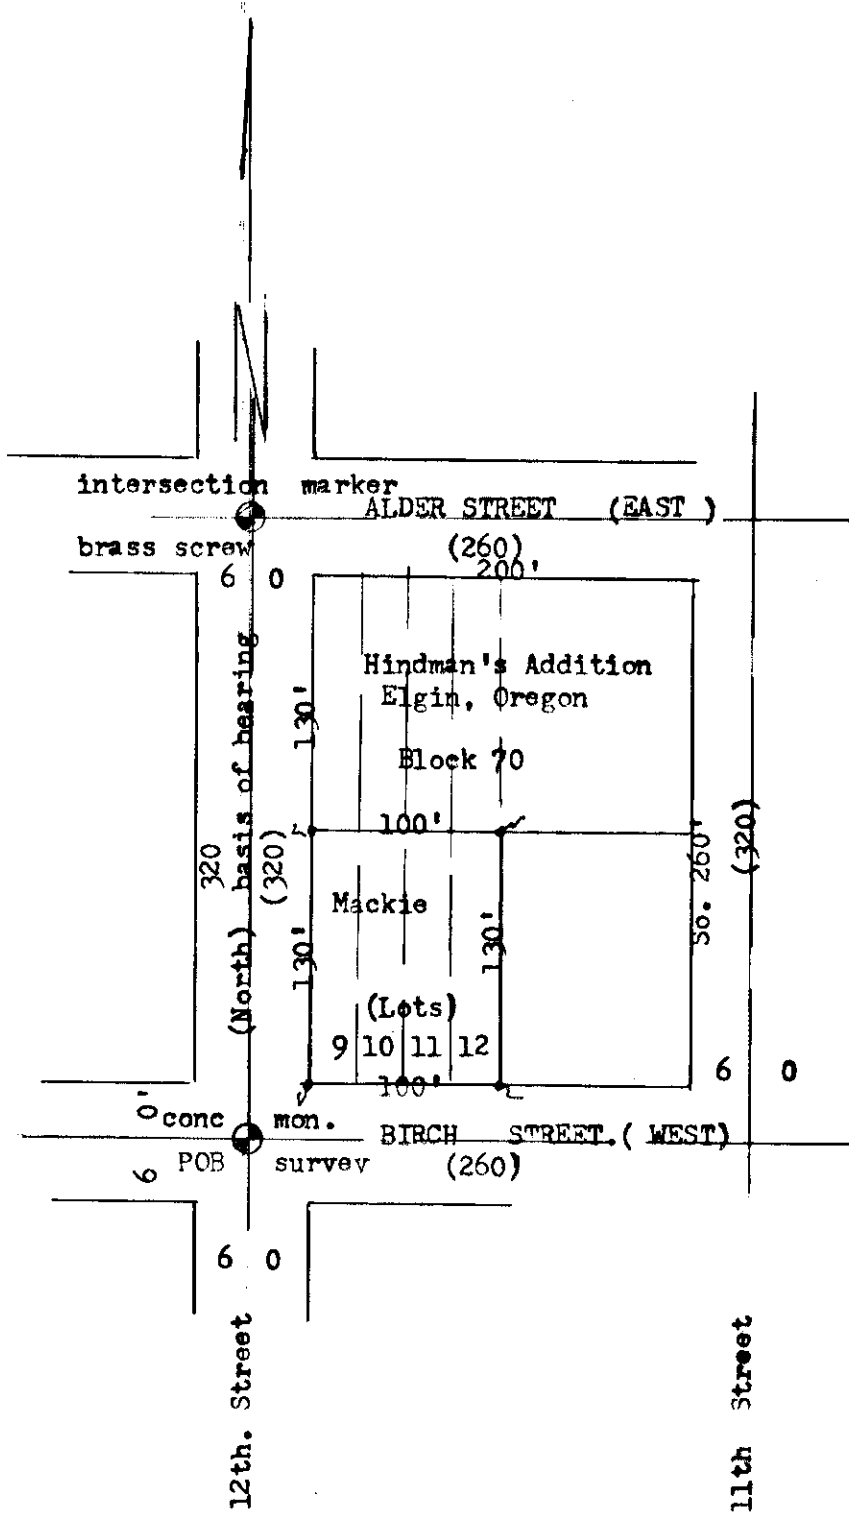

( ) data of record  
— set 5/8" x 30" steel rod.

REGISTERED  
PROFESSIONAL  
LAND SURVEYOR  
*James G. Voelz*  
OREGON  
MAY 4, 1972  
JAMES G. VOELZ  
381

13-72

12-1972