


Herbert H. & Devonna Mackie
Elgin, Oregon

March 20, 1972

scale 1" = 200'

set 5/8"x30" Steel rod
() data of record.

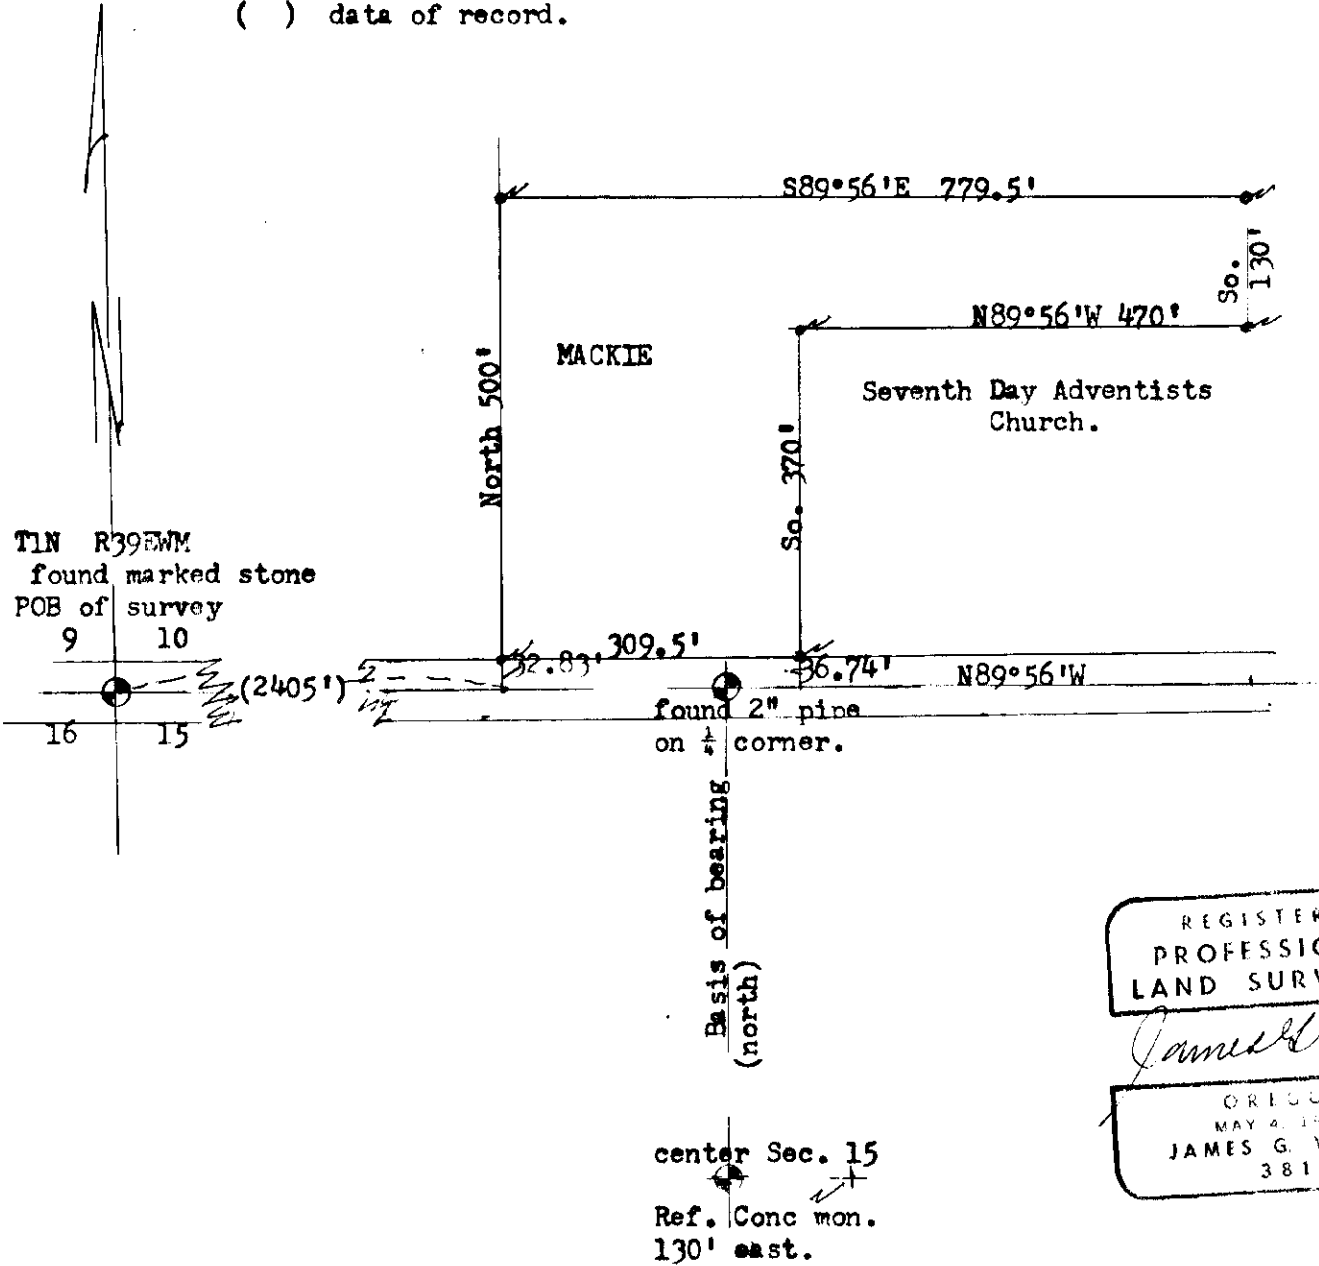

14-72

14-1972