


Merle .L. & Ella C. Sherburn
Cove, Oregon

Scale 1" = 200'

April 7, 1972

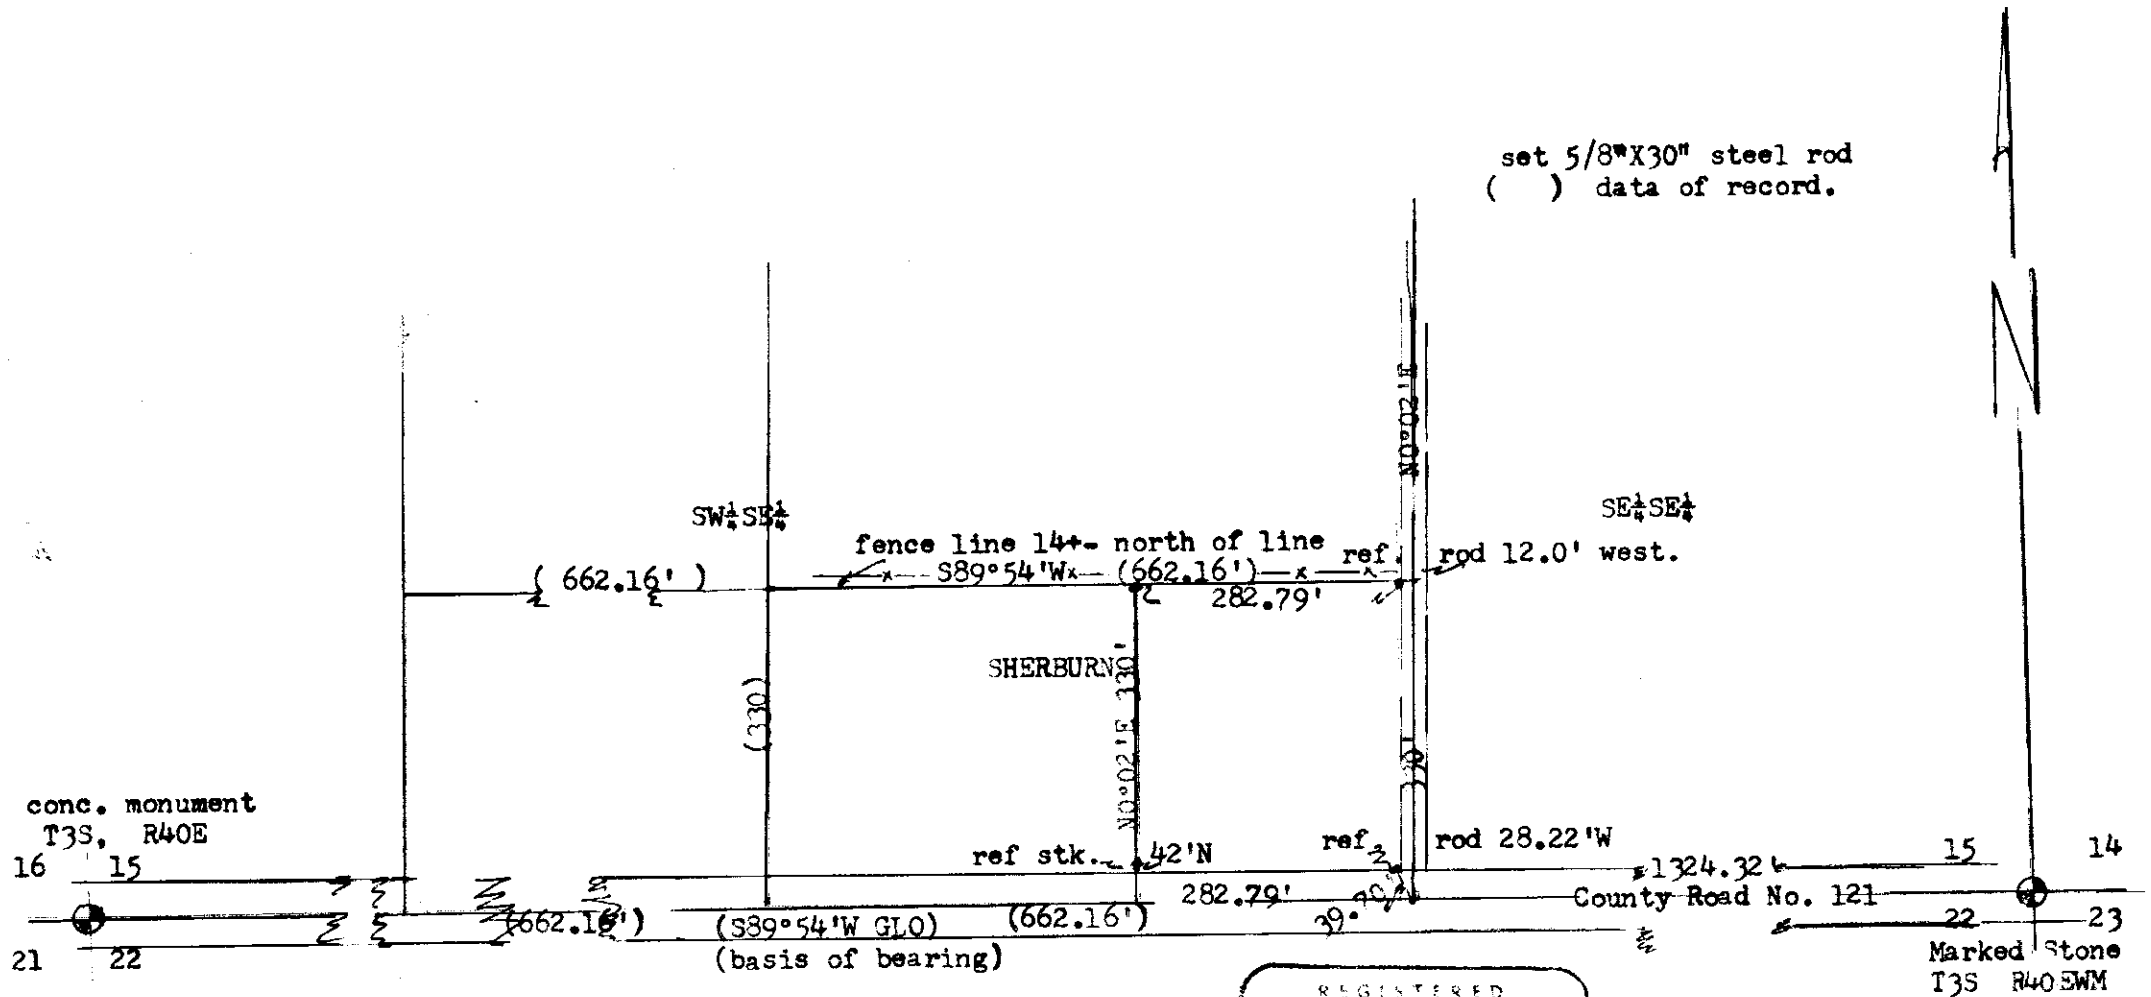

REGISTERED
PROFESSIONAL
LAND SURVEYOR

James G. Voelz

OREGON
MAY 2, 1956
JAMES G. VOELZ
381

15-72

1592