


Nora Royes
 Box 482
 Union, Oregon

April 8, 1972

scale 1" = 100'

- set 5/8"x30" steel rod
- () data of record.
- corner markers found.

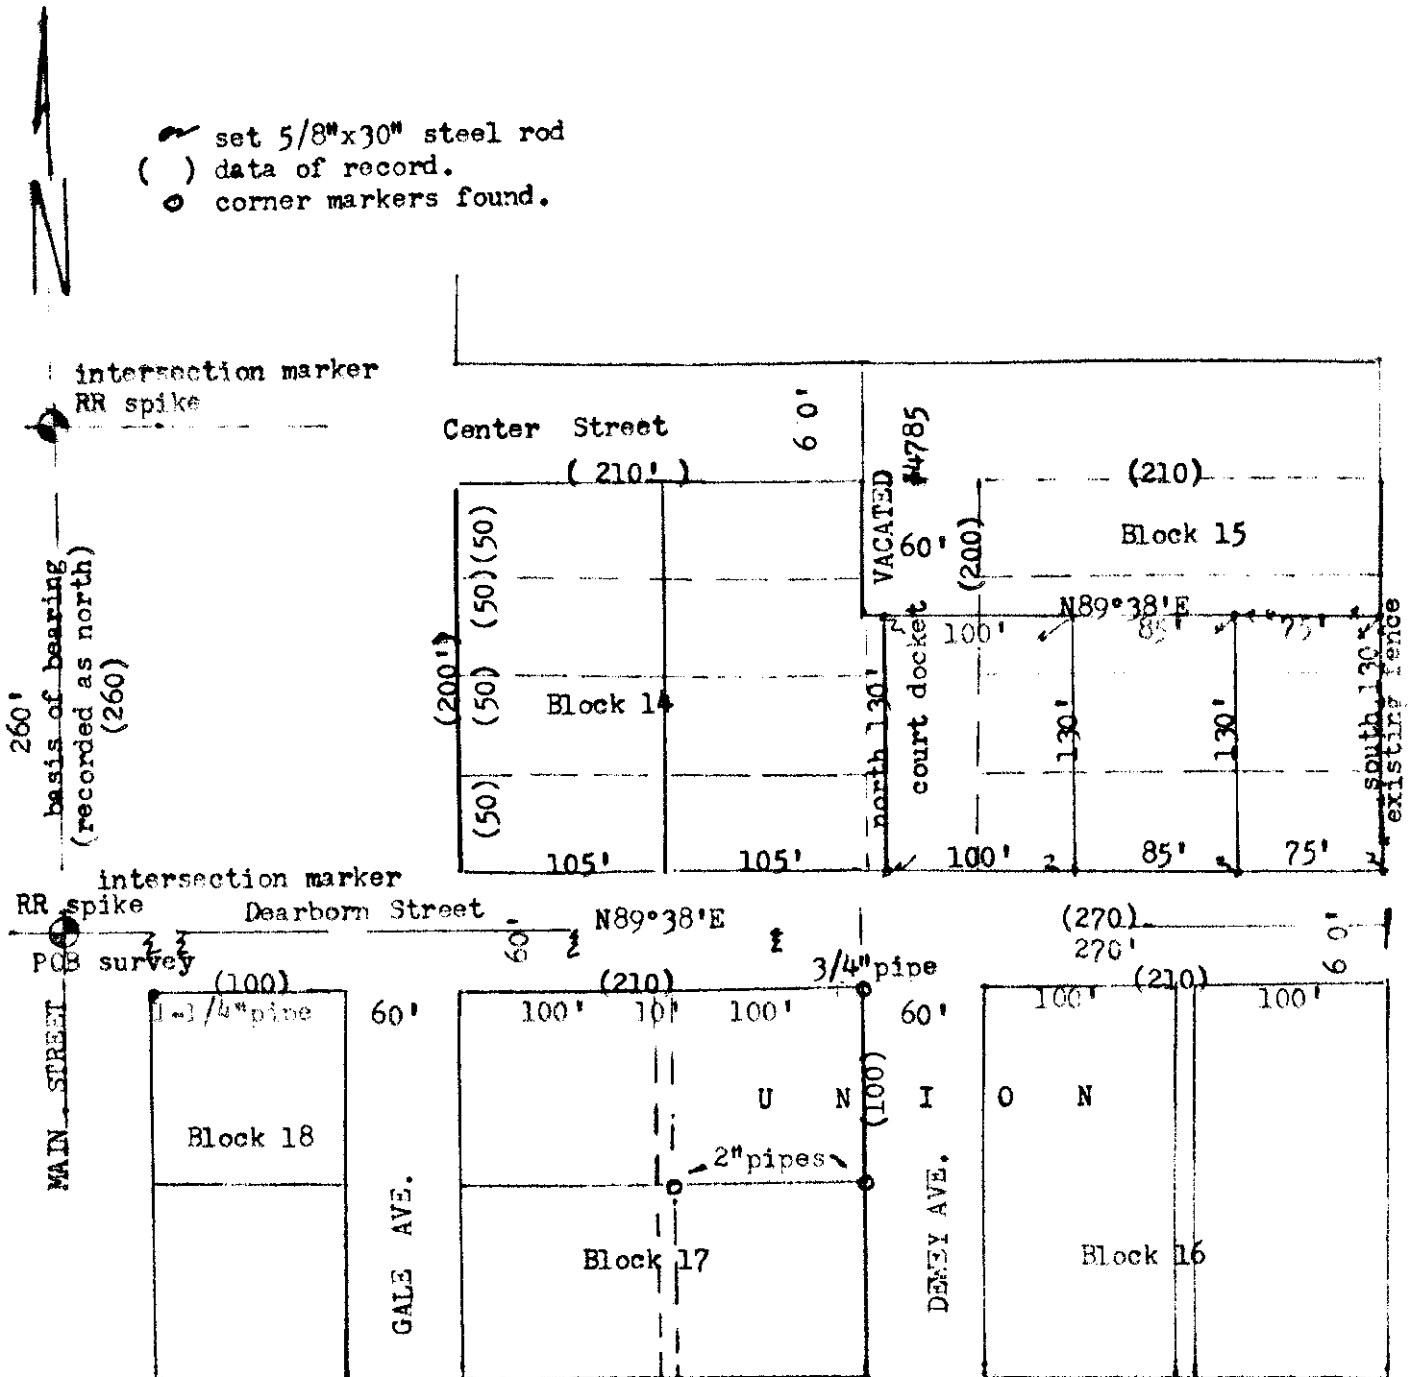

REGISTERED
 PROFESSIONAL
 LAND SURVEYOR
James G. Voelt
 JAMES G. VOELT
 381

1972

17-72