

Robert Gruis
Mt. Glenn Road
La Grande, Oregon



April 20, 1972

Scale 1" = 100'

set 5/8"X30" steel rod.
data of record
corners found

conc. mon.
Division Ave.

RIVERSIDE ADDITION

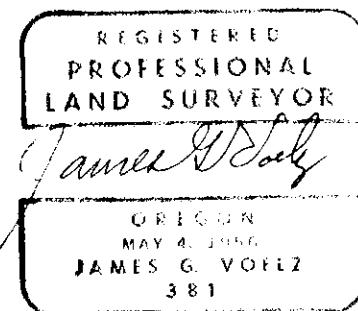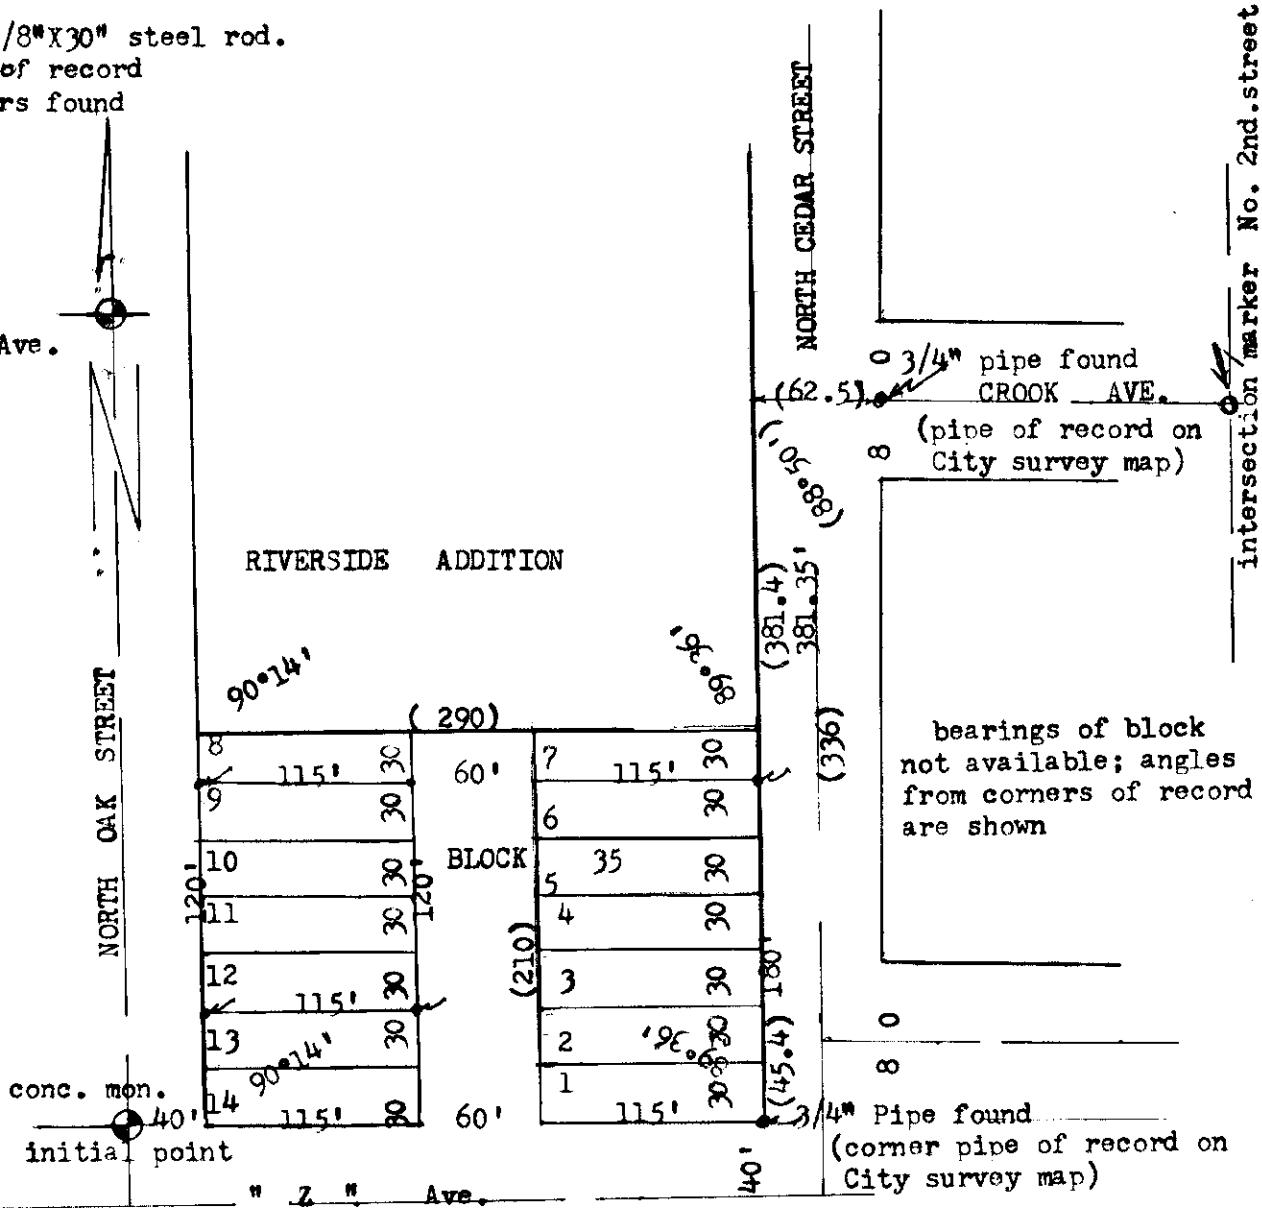

18-1972