


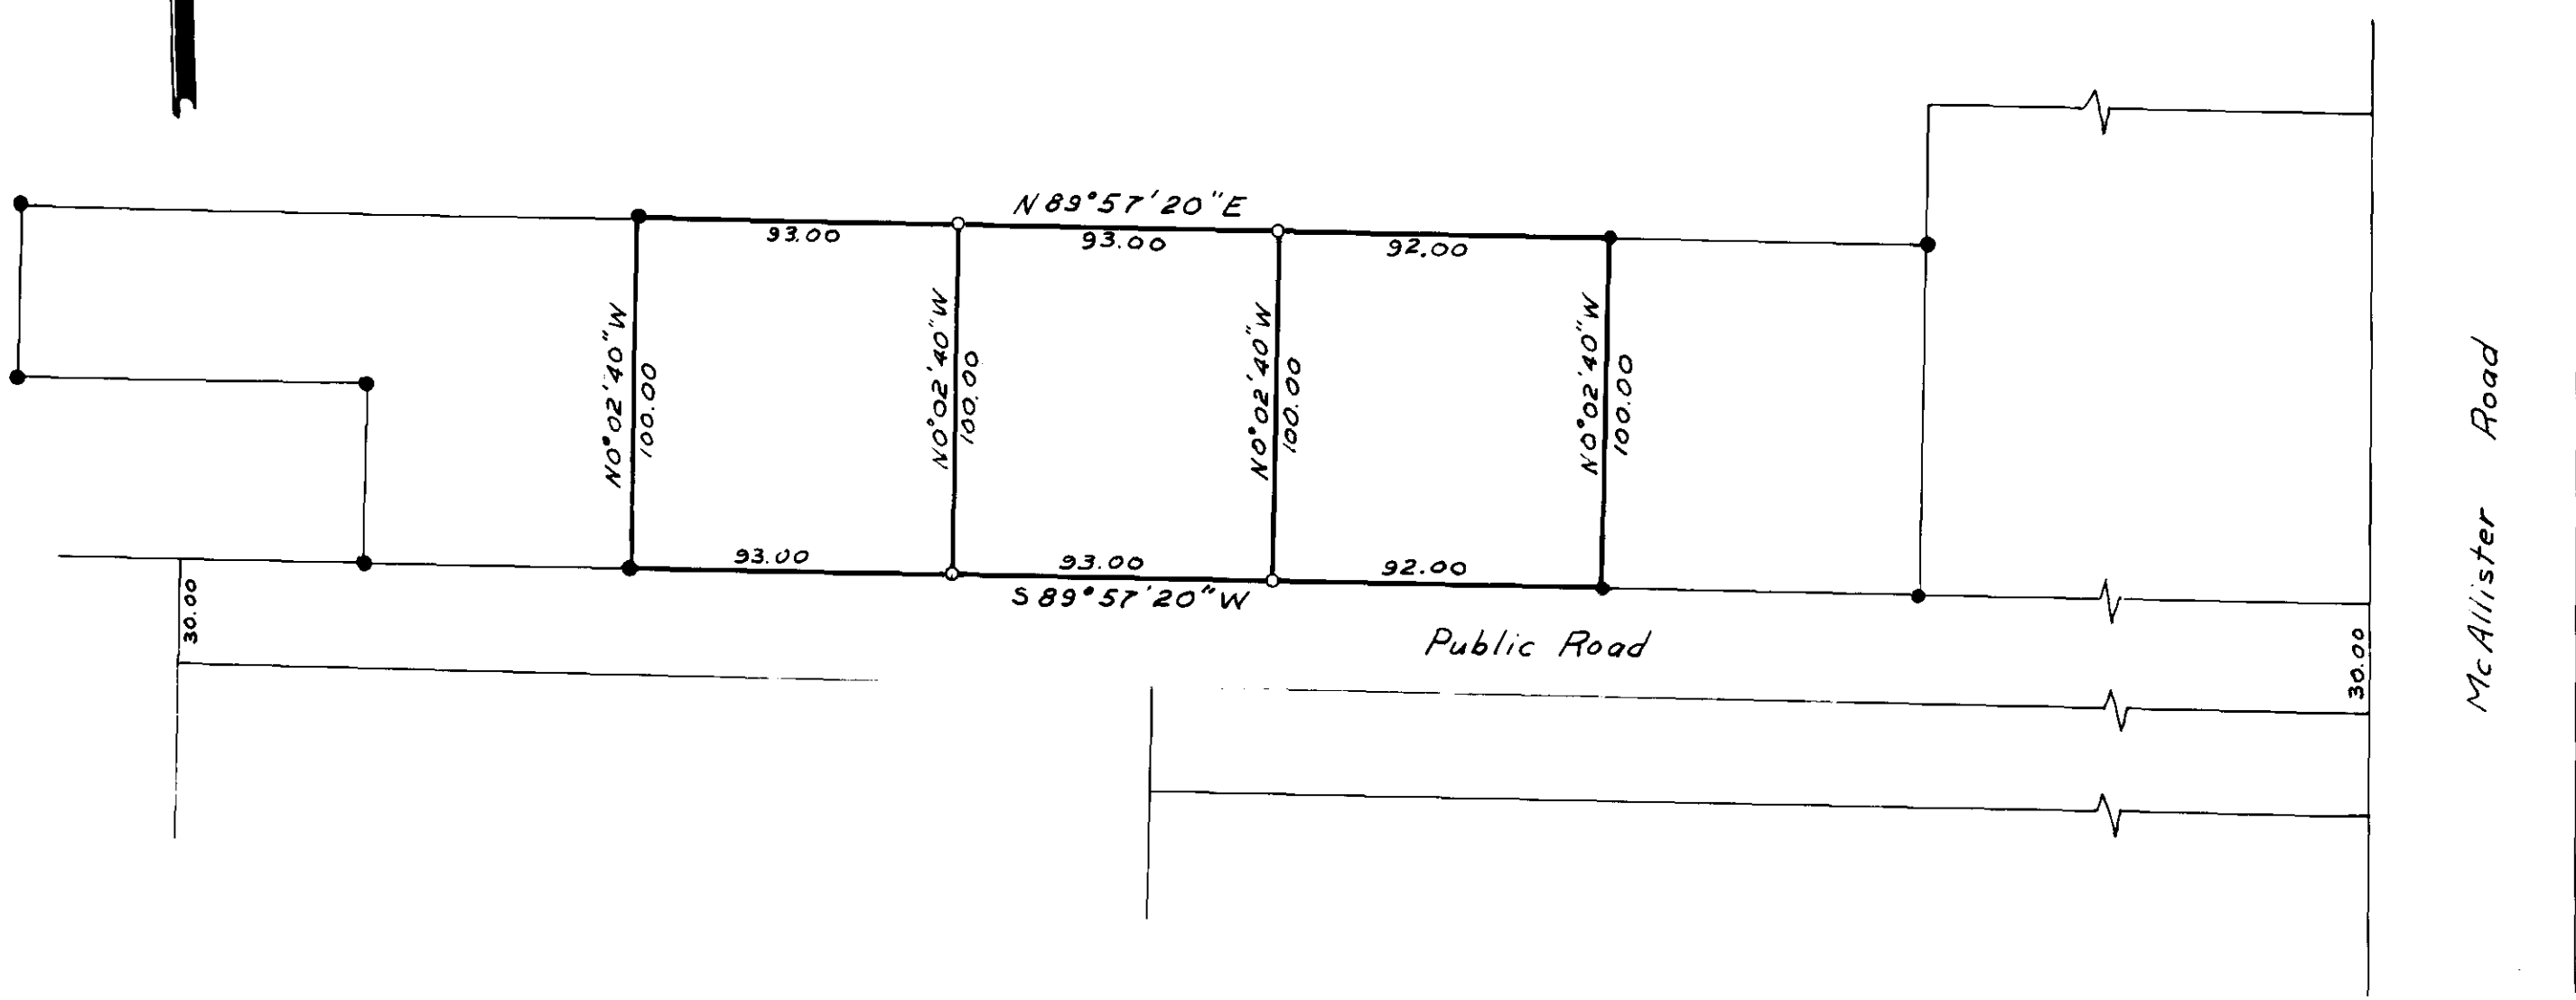

BASIS OF BEARINGS

Survey No. 56-71



REFERENCE MATERIAL

Map of Survey No. 56-71


LEGEND

- Fd. Monument of Record
- Set 1/2" x 24" iron pin

REGISTERED  
PROFESSIONAL  
LAND SURVEYOR

*Duane I. Griffith*

OREGON  
JULY 10, 1964  
DUANE I. GRIFFITH  
644

 <b>BAGETT-GRIFFITH-FERGUSON</b> LaGrande, Oregon Map of Survey		
Parcels in the SE 1/4 of the NW 1/4 Section 3T35R38E W.M. Island City UNION COUNTY, OREGON		
SURVEYED FOR	Dale Young	by DIG
DESIGNED FOR		by
Scale: 1" = 50'	Drawn by DIG & LT	May 1972