


Frank Lovely
 Russell Street
 La Grande, Oregon

cor. not found

T2S, R38EWM	32	33
T3S, R38EWM	5	4

May 8, 1972

- 5/8" X 30" steel rod.set
- 3/4" pine found
- conc mon. found
- () data of record

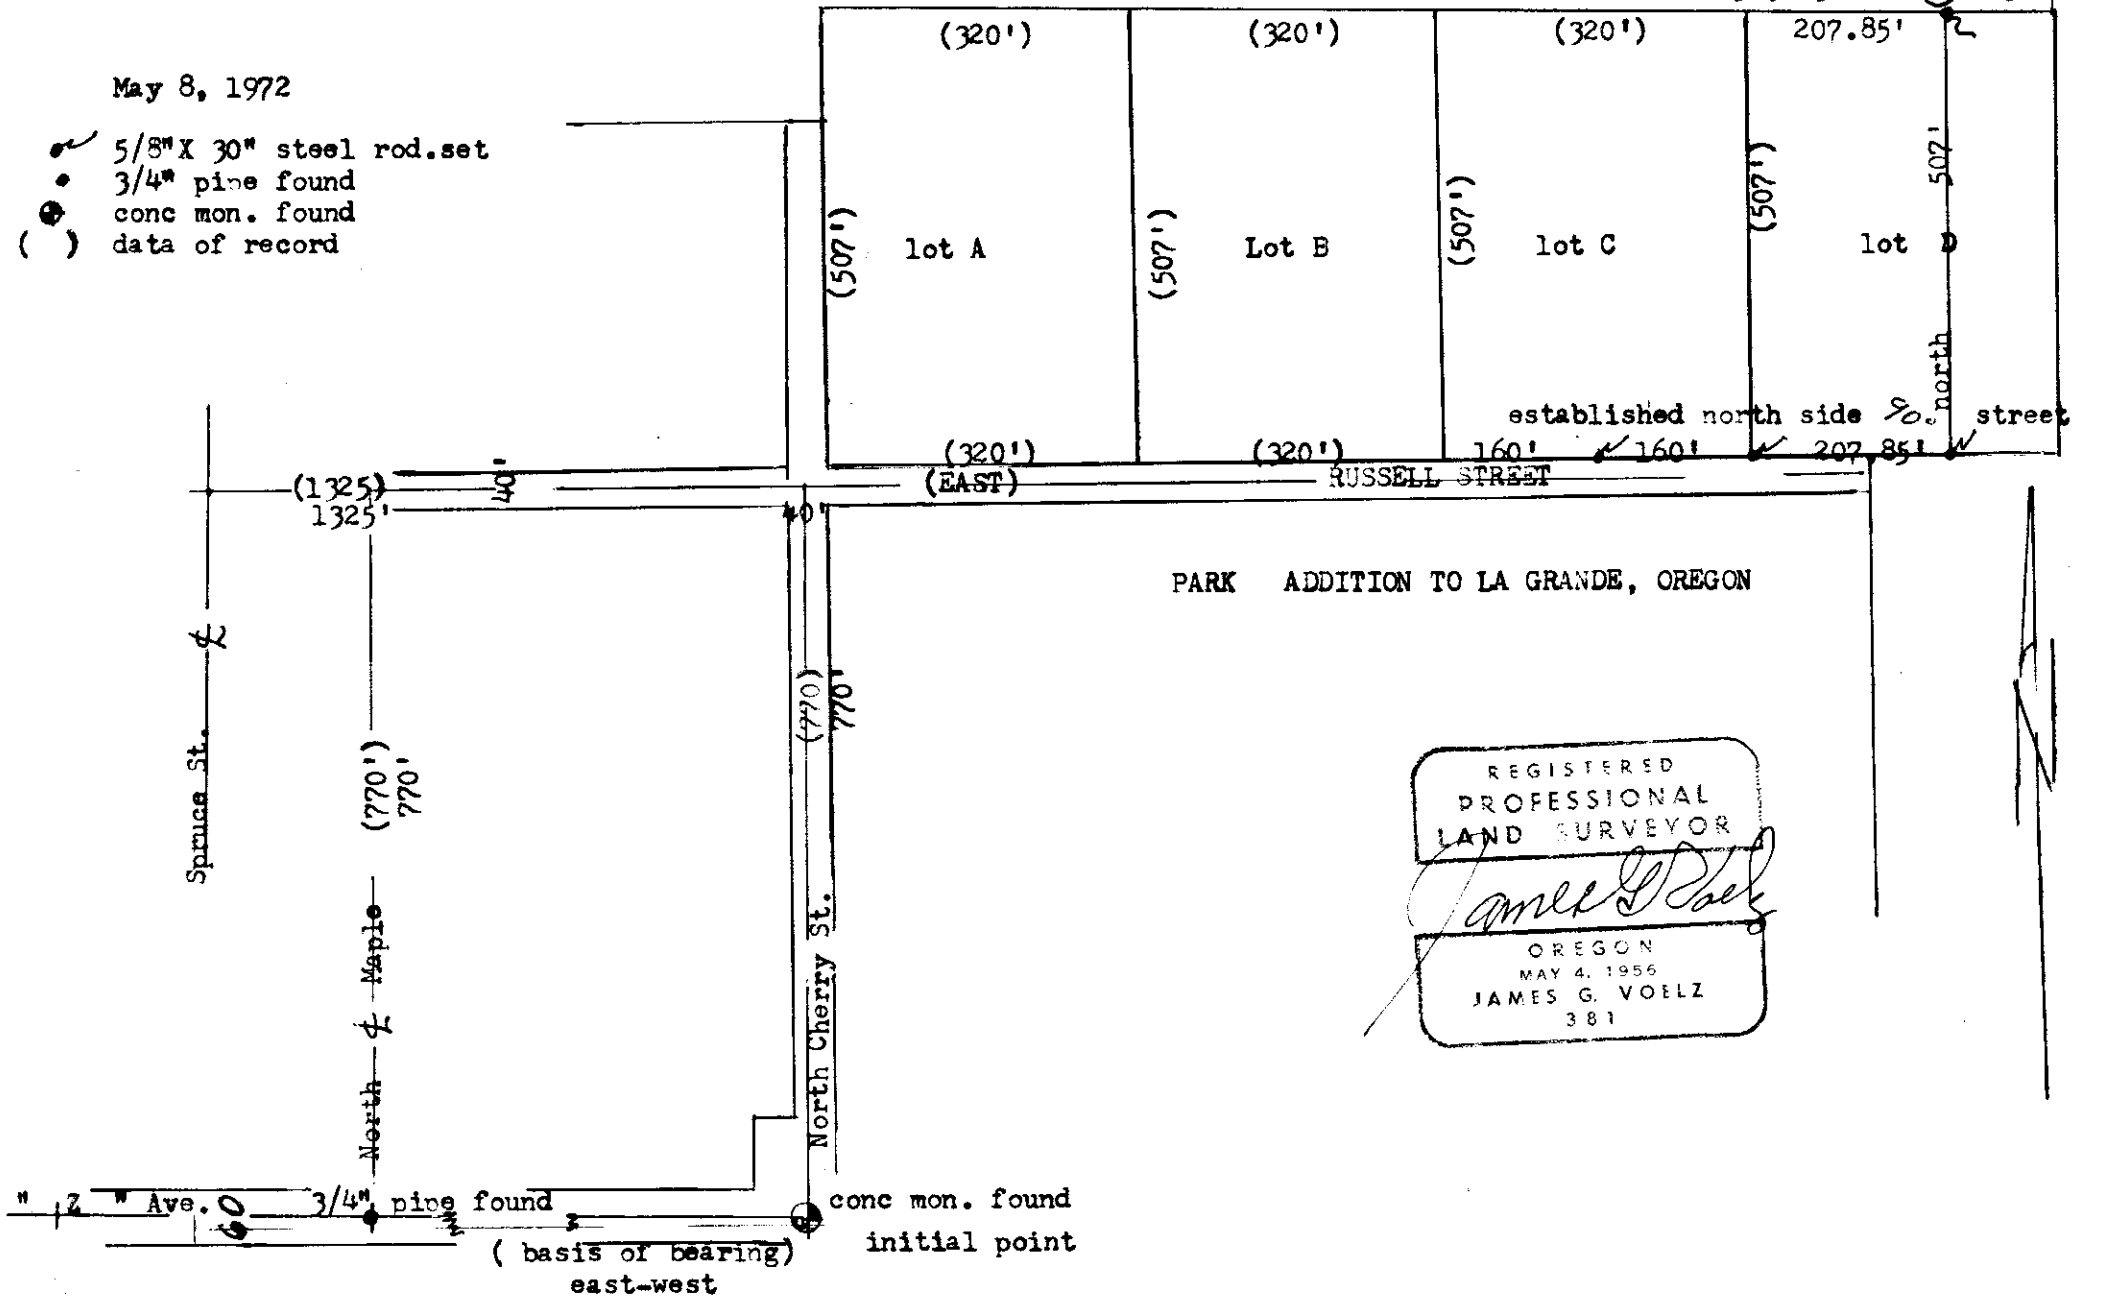

84-72