


John Leddy &  
Imbler, Oregon

March 20, 1972

Scale 1" = 100'

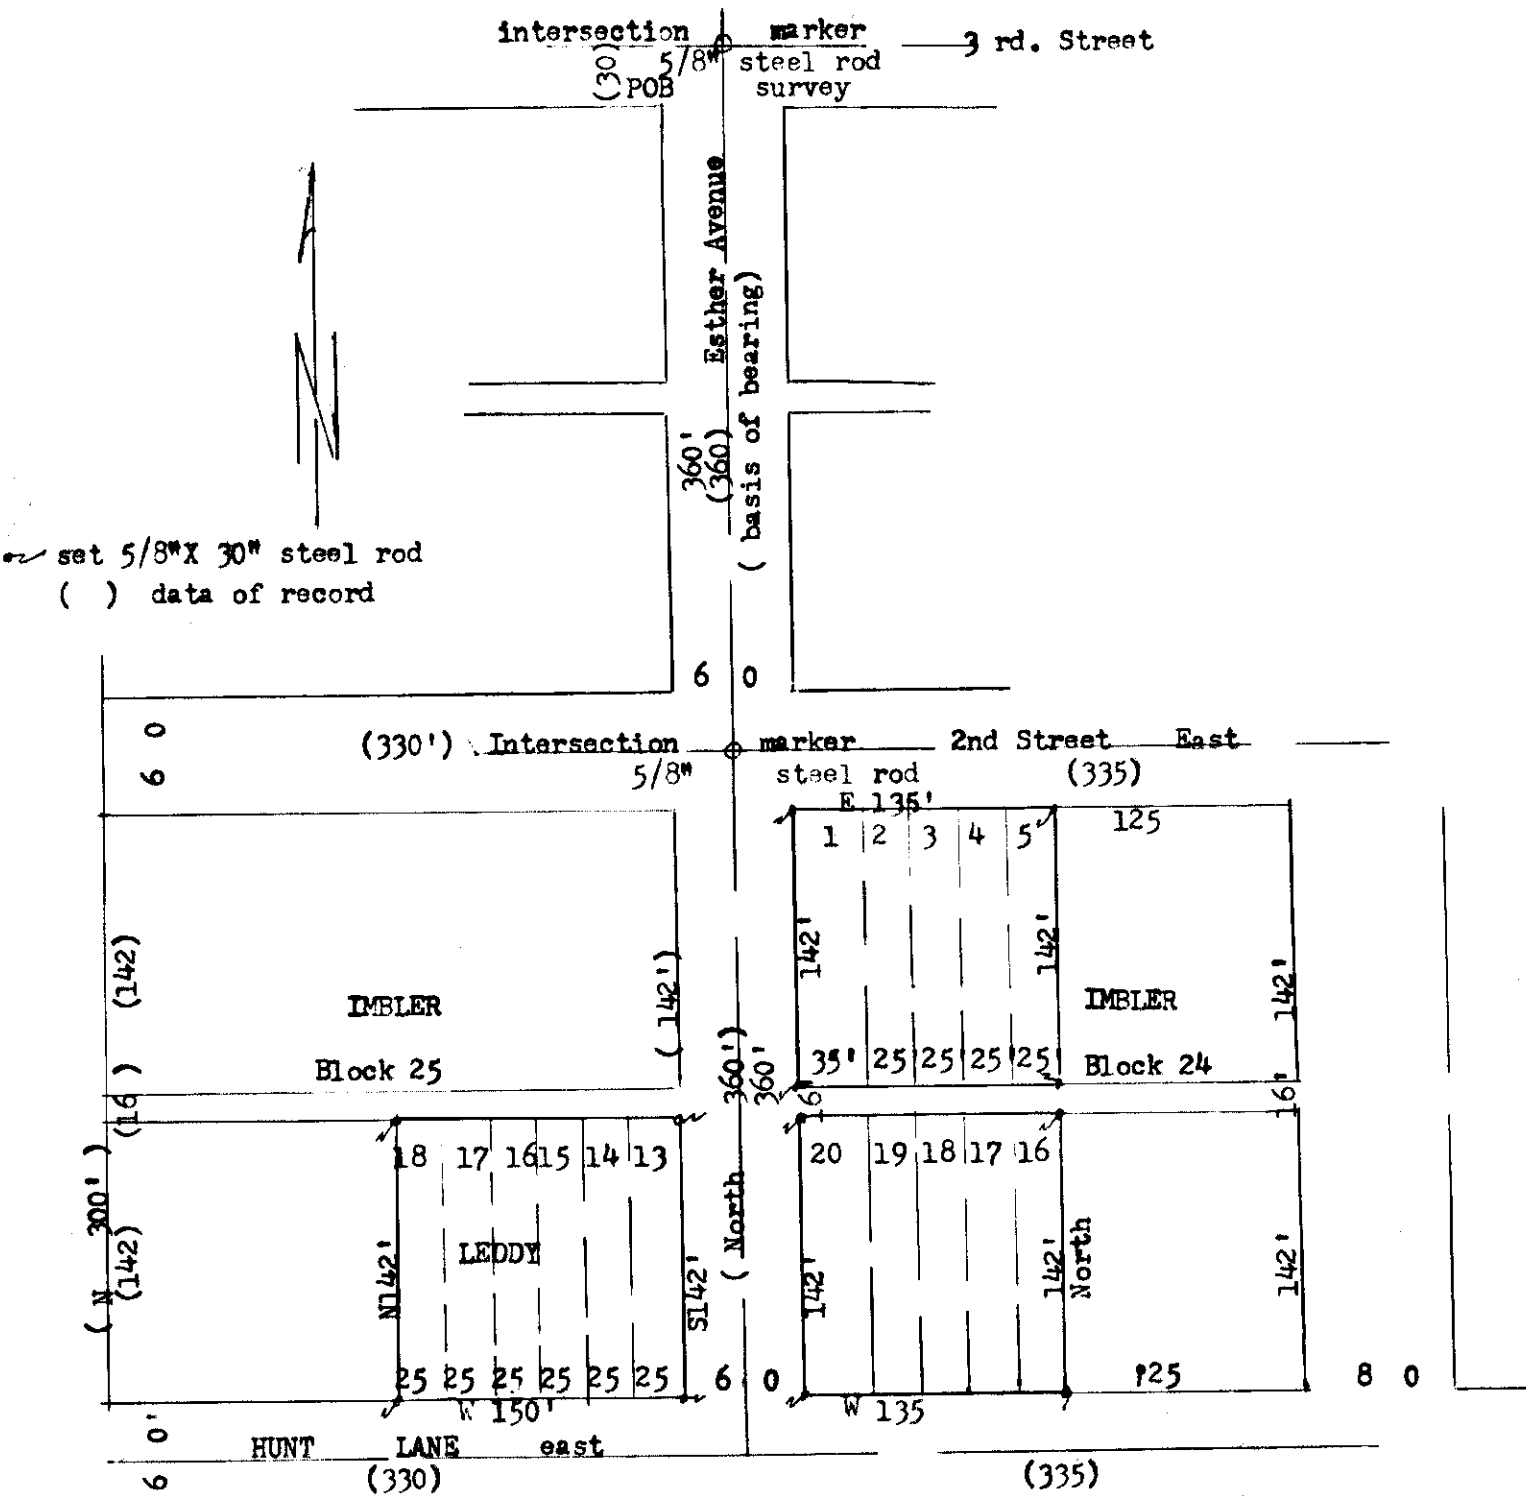

41 -  
39-1972