


Mrs. Ilo Fields
1900 Z
La Grande, Oregon

5 July, 1972

scale 1"=100'
set 5/8"X30" steel rod
data of record ()

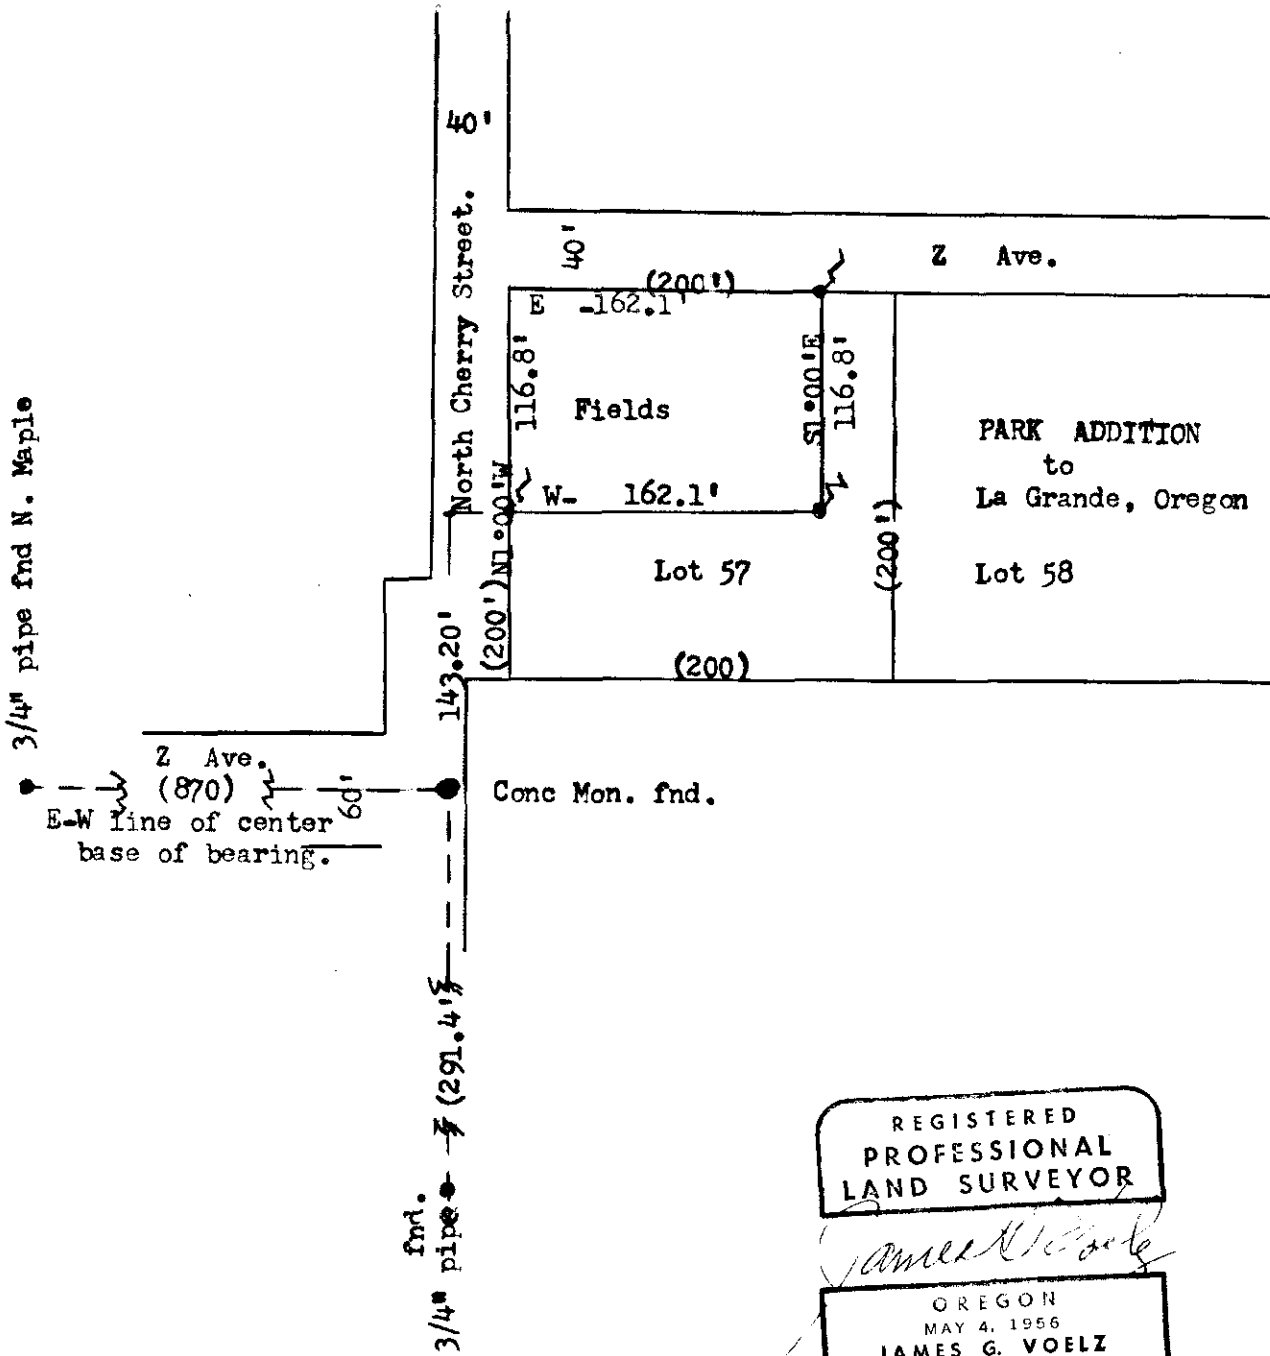

REGISTERED
PROFESSIONAL
LAND SURVEYOR
James G. Voelz
OREGON
MAY 4, 1956
JAMES G. VOELZ
381