


Valley Realty
Island City, Oregon

June 24, 1972

scale 1" = 200'

✓ set 5/8" steel rod x 30" long.
() data of record.

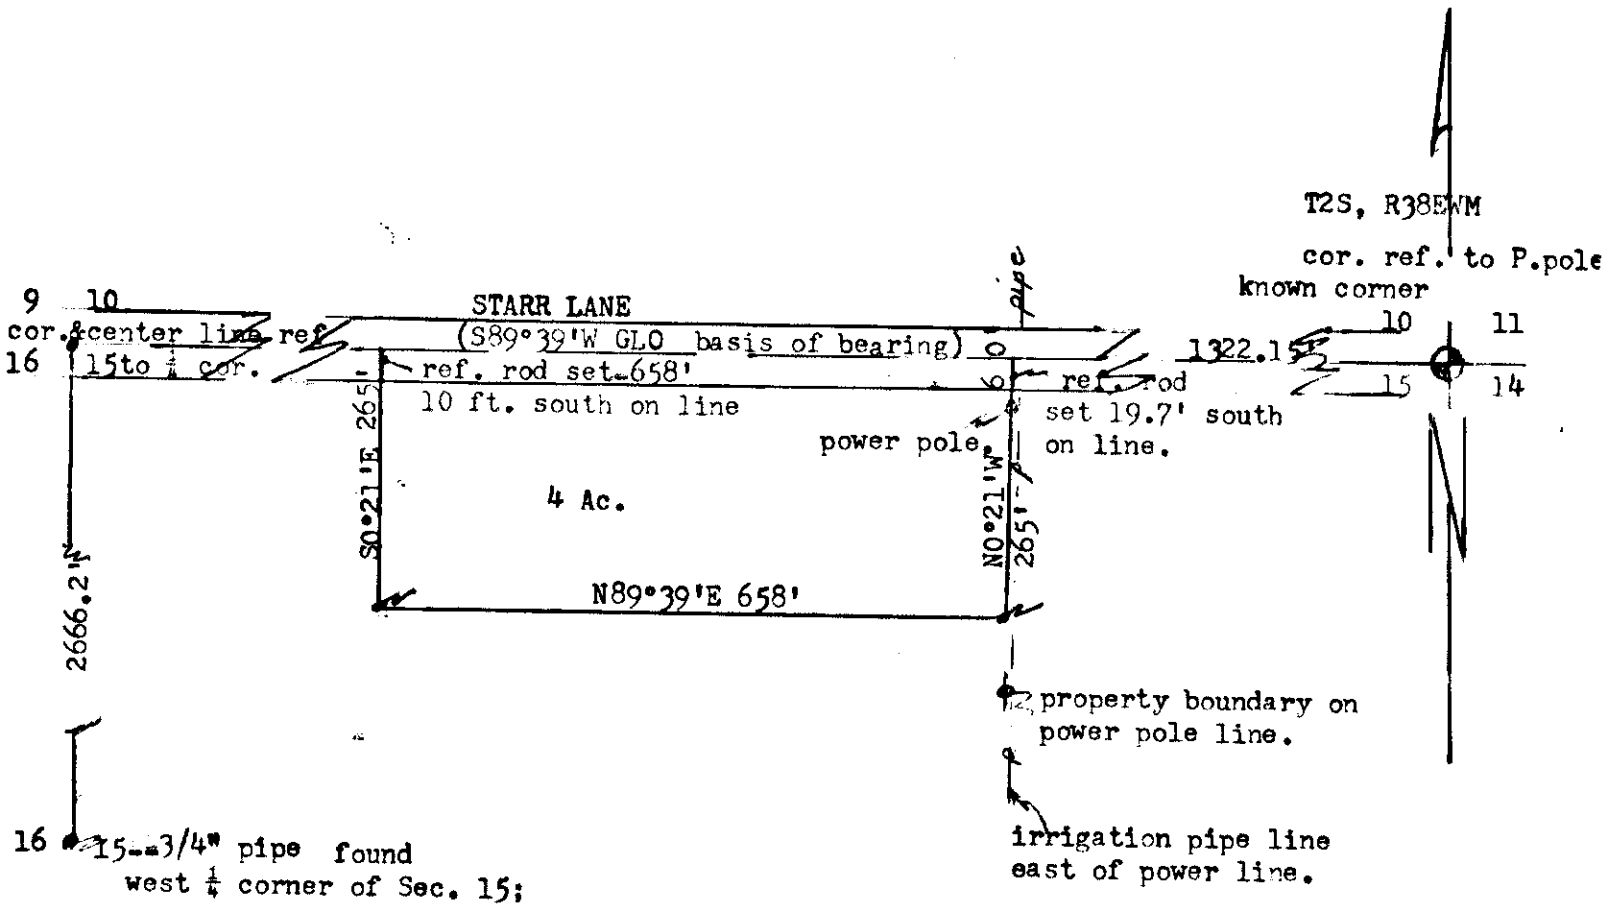

REGISTERED
PROFESSIONAL
LAND SURVEYOR

James G. Voelz
OREGON
MAY 4, 1956
JAMES G. VOELZ
381