


Gerald Brown
 "W" Ave.
 La Grande, Oregon

June 28, 1972

scale 1" = 60'

{ set 5/8" X 30" steel rods
 () data of record

steel nail

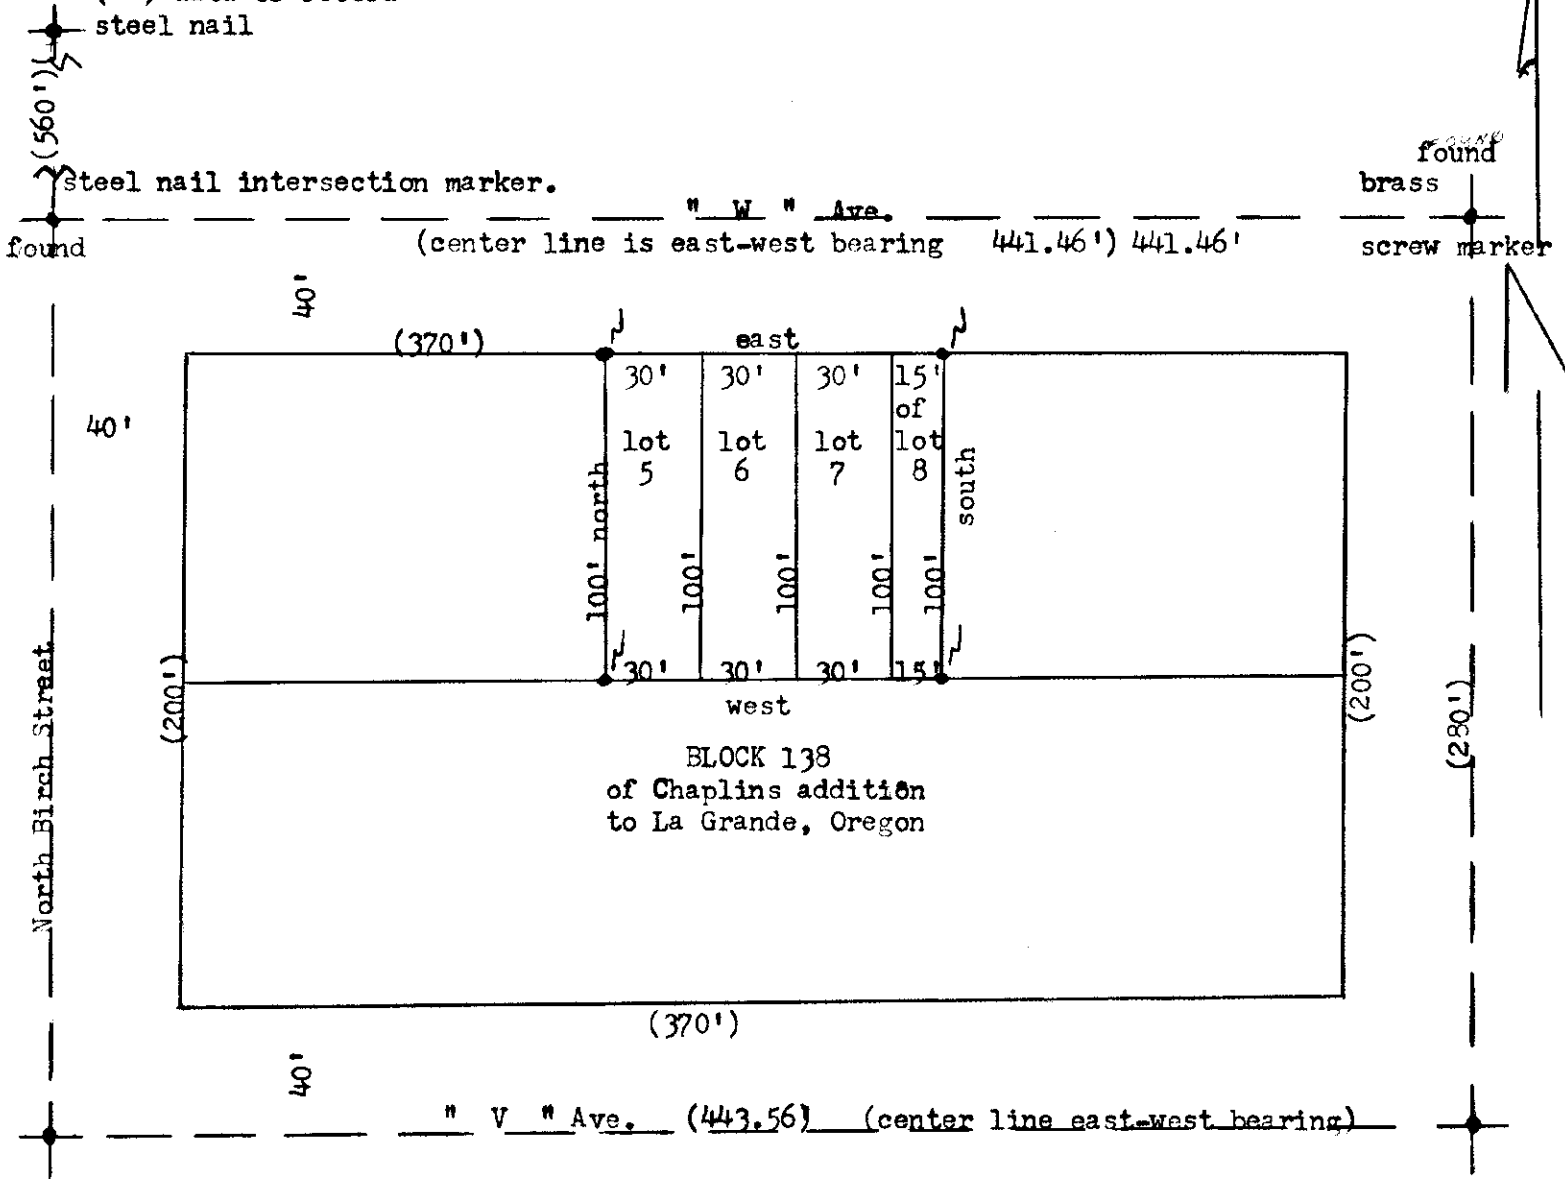

REGISTERED
 PROFESSIONAL
 LAND SURVEYOR

James G. Voelz

OREGON
 MAY 4, 1956
 JAMES G. VOELZ
 381

56-72