


Oscar L. & Rita M. Jacobson
Rt. 1, Box 1475
La Grande, Oregon

June 26, 1972

scale 1" = 400'
set 5/8" steel rod X30" long
() data of record

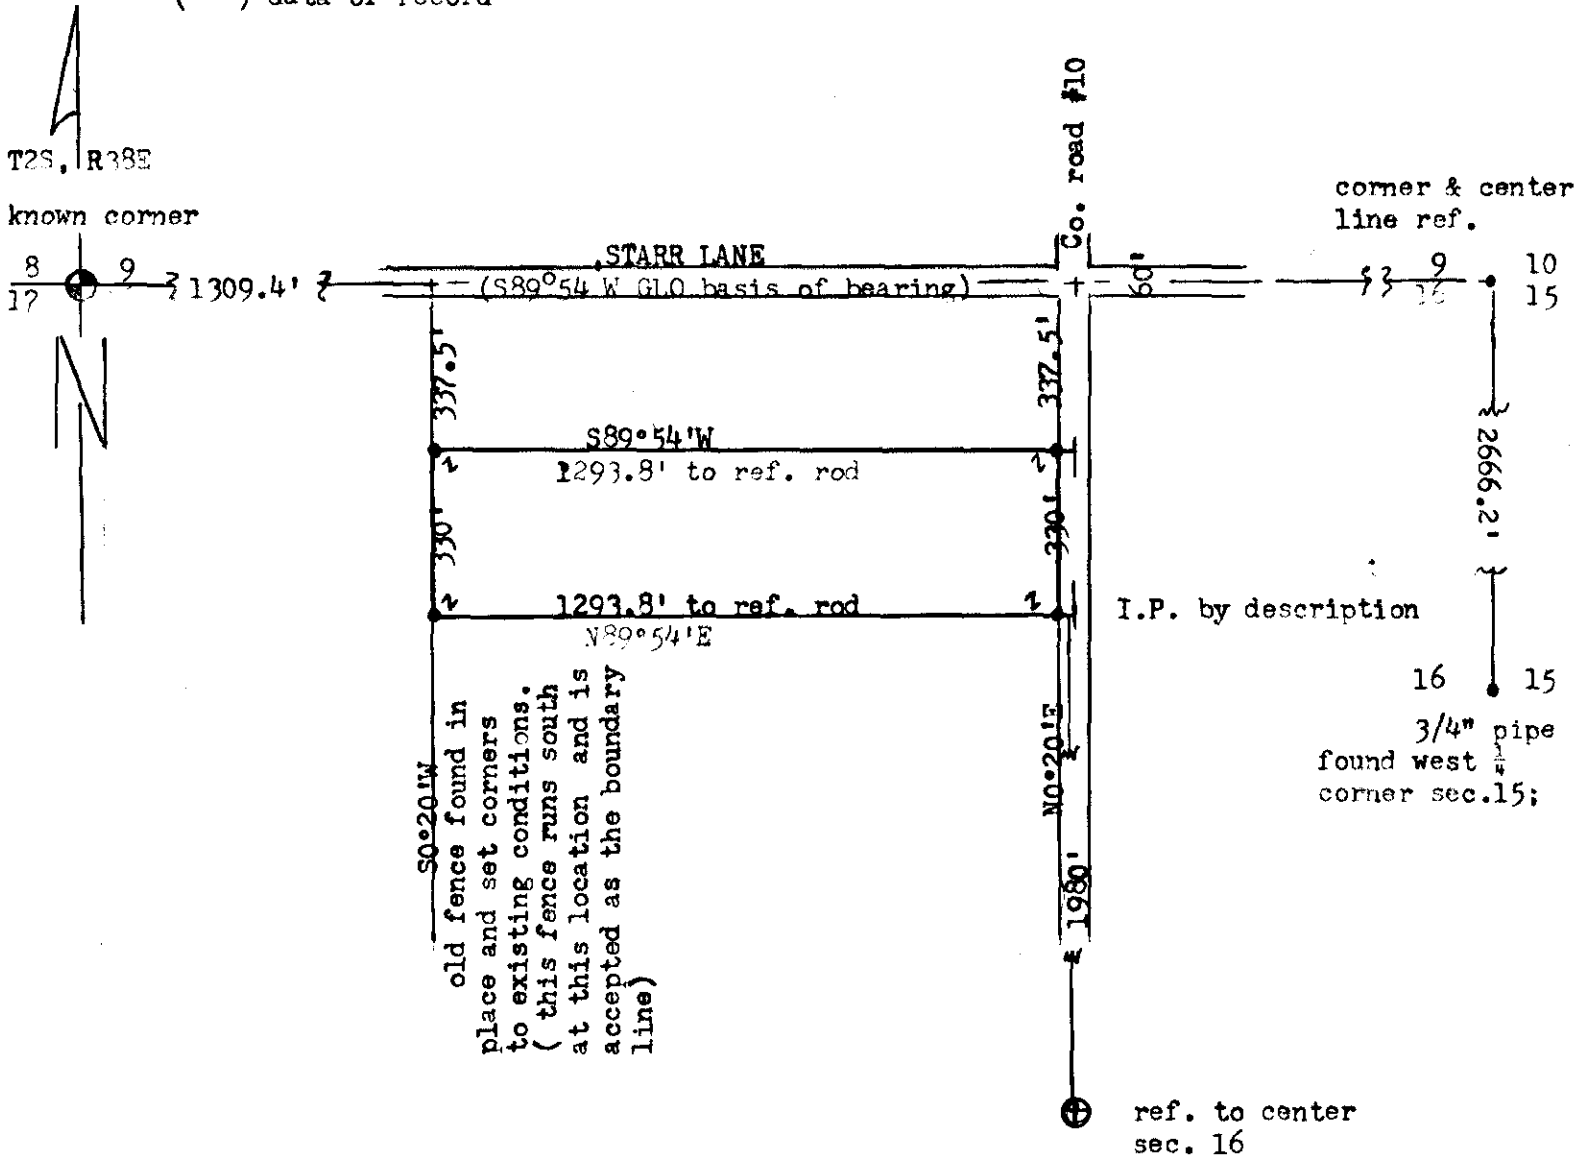

REGISTERED
PROFESSIONAL
LAND SURVEYOR

James E. Noels
OREGON
JAMES E. NOELS
281