


J.I. Agnor  
 Rt. 1 Box 38  
 Elgin, Oregon

scale 1" = 50'  
 Aug 7, 1972  
 ( ) data of record.  
 set 5/8" X 30" steel rod.

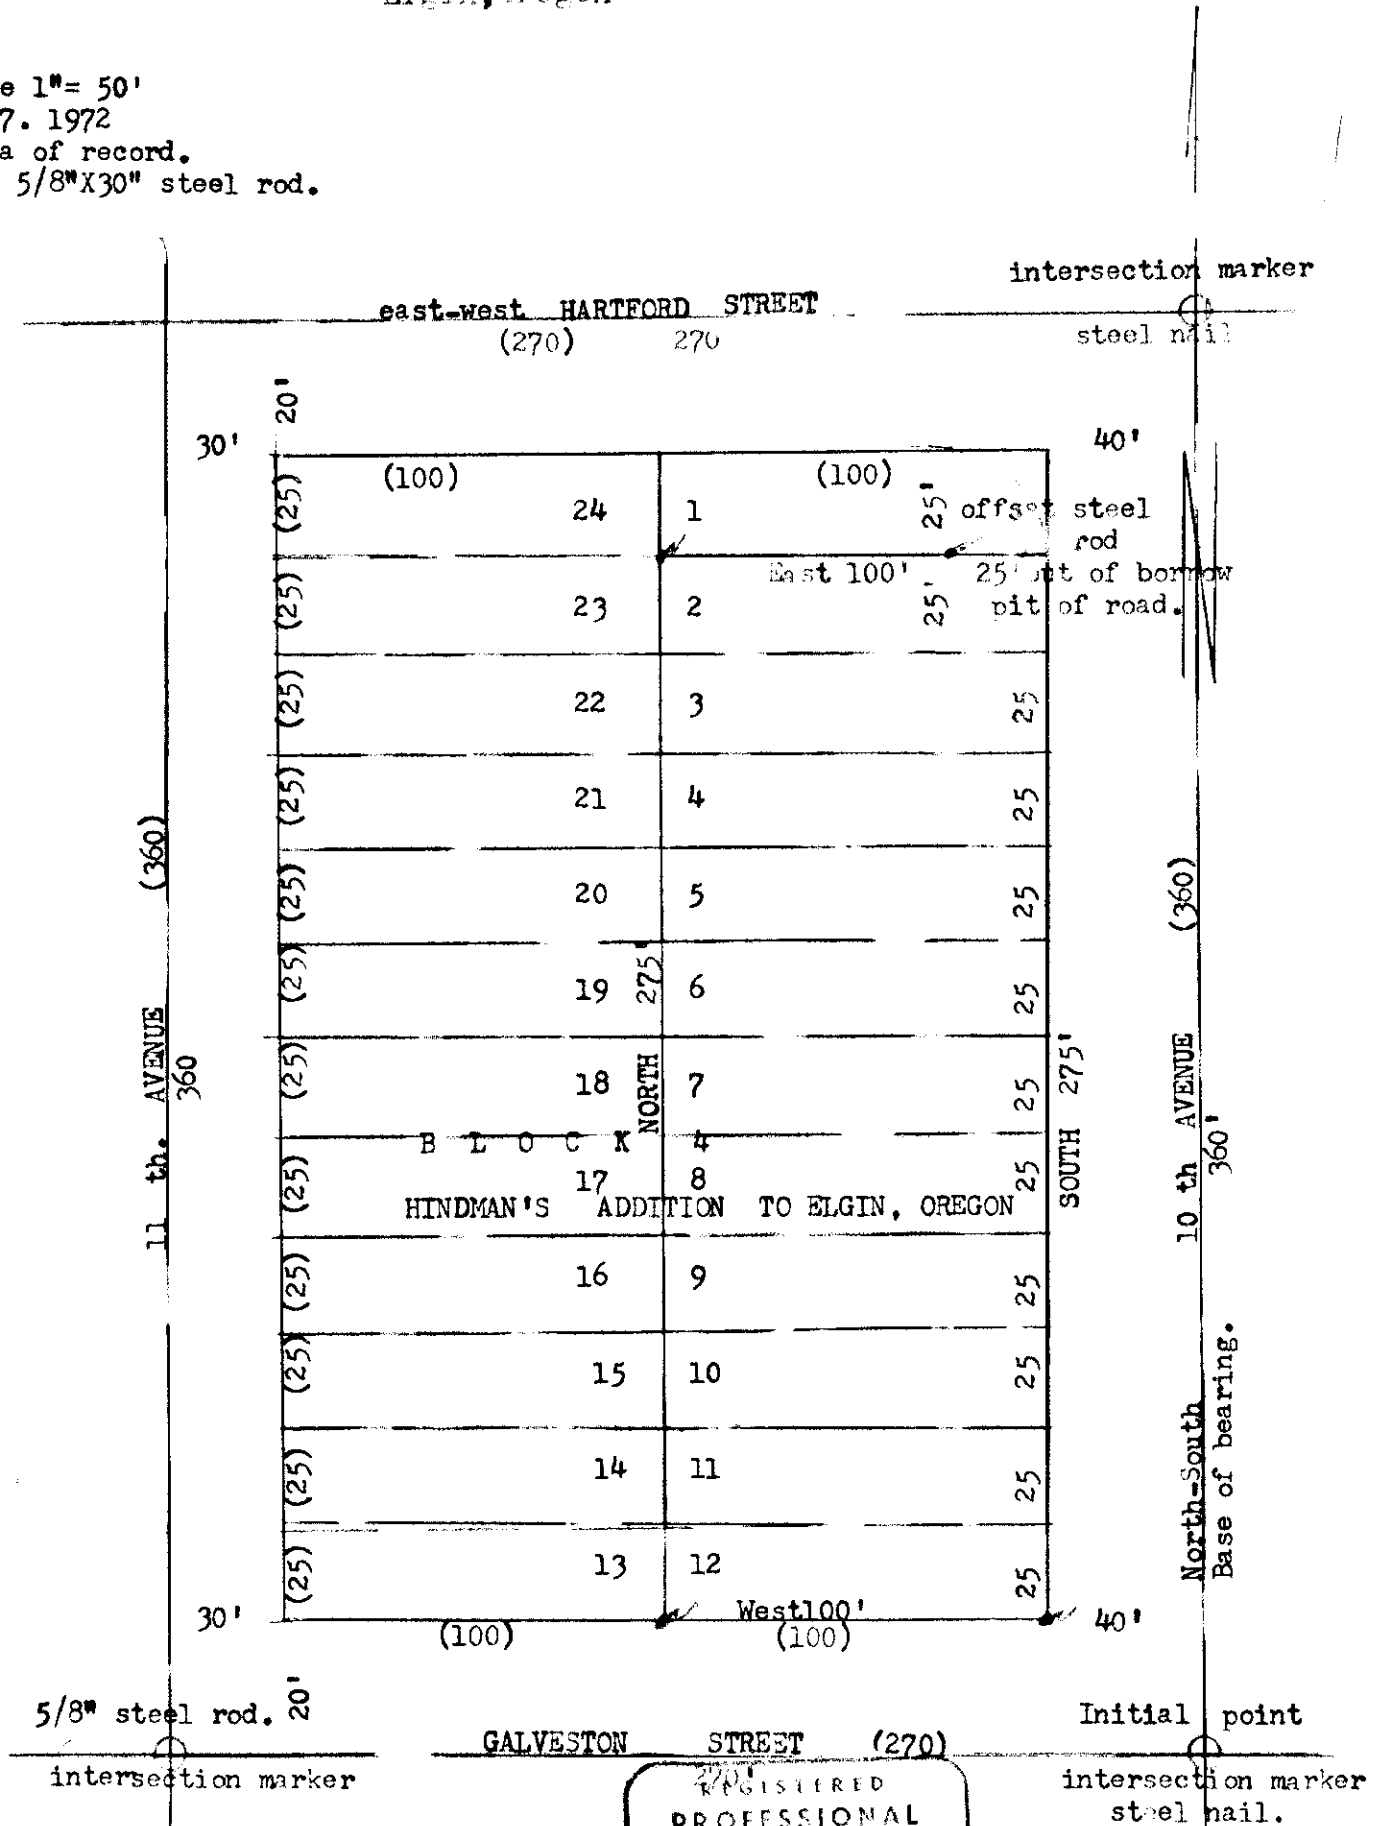

REGISTERED  
 PROFESSIONAL  
 LAND SURVEYOR

*James G. Voelz*  
 OREGON  
 MAY 4, 1963  
 JAMES G. VOELZ  
 381

63-1972

63-72