EDNA O. INGRAM
2807 North Depot Street
La Grande, Ore.
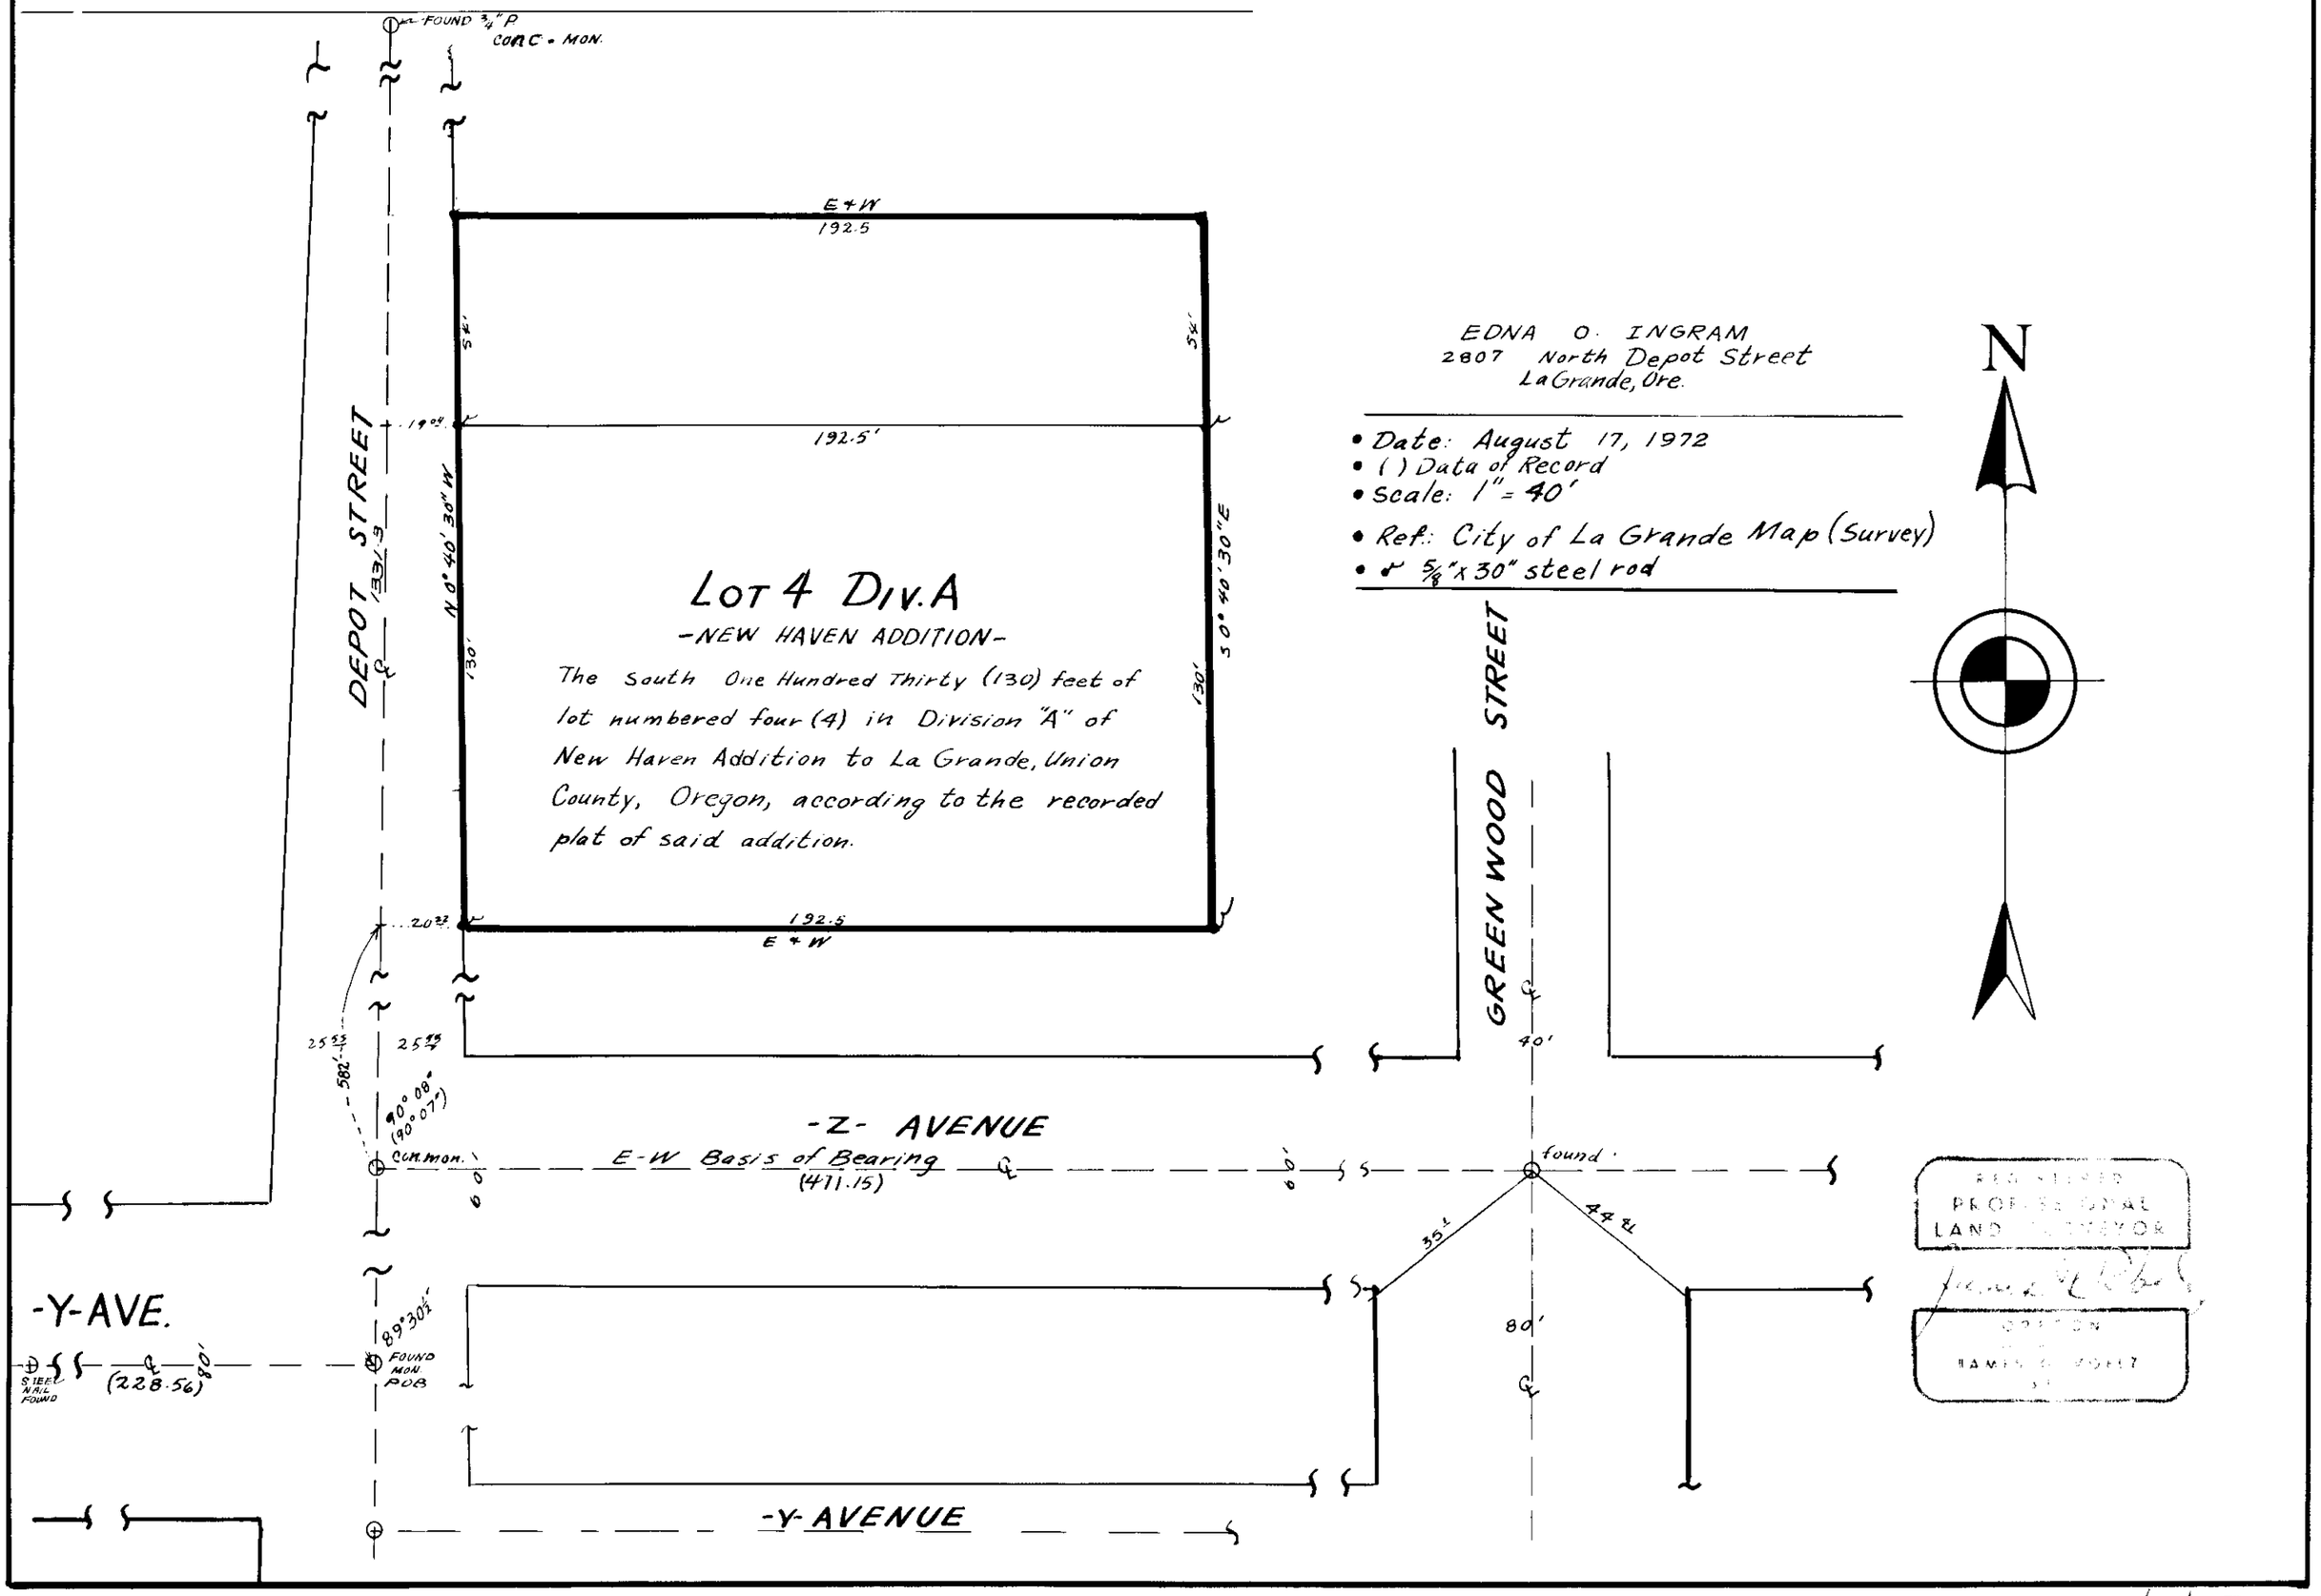
- Date: August 17, 1972
- ( ) Data of Record
- Scale: 1" = 40'
- Ref.: City of La Grande Map (Survey)
- ● 5/8" x 30" steel rod