John Ray
Elgin, Oregon

Aug. 7, 1972
Scale 1"= 50
set 5/8"X30" steel rod.
( )data of record.

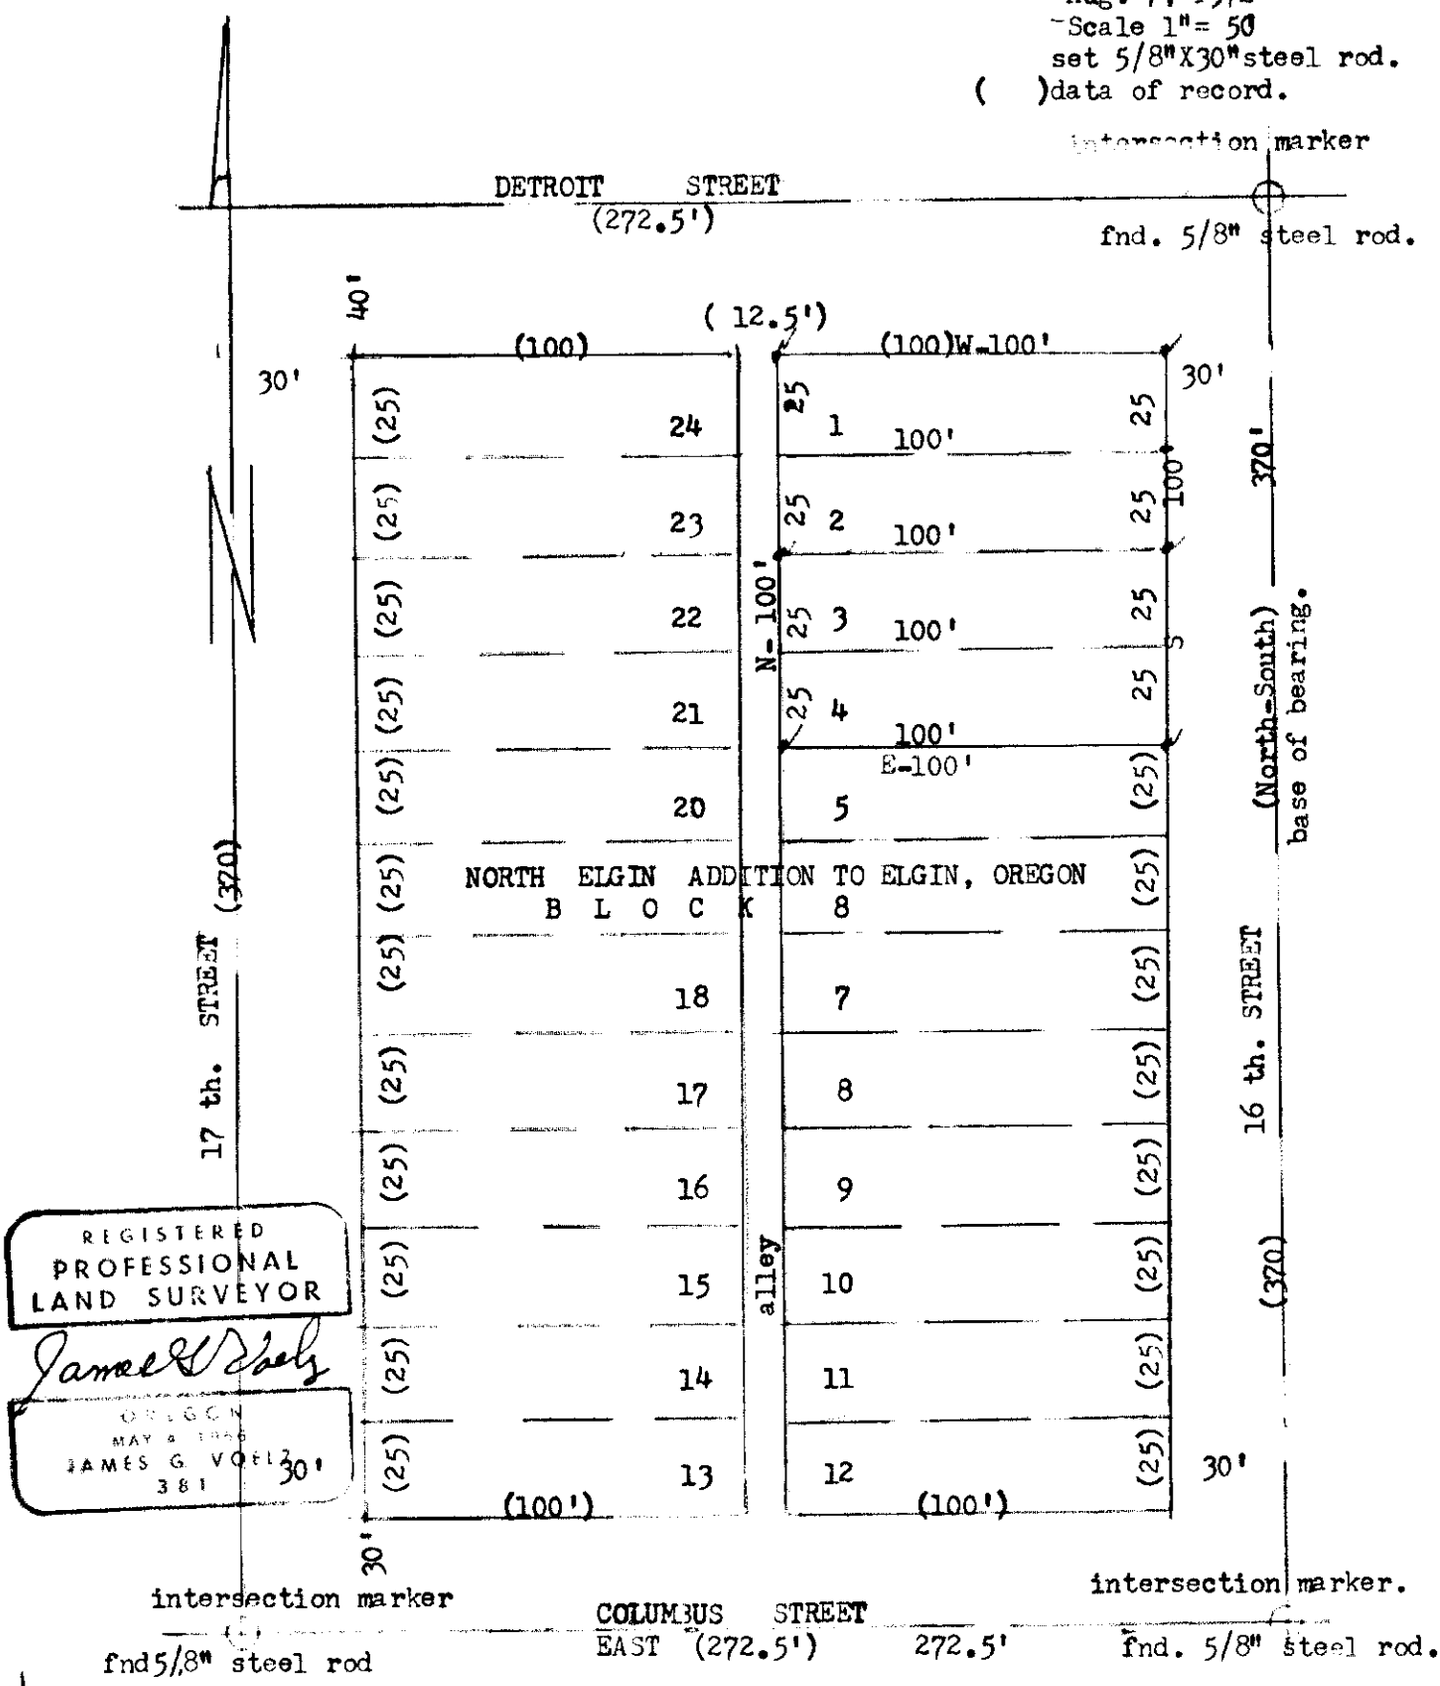

REGISTERED
PROFESSIONAL
LAND SURVEYOR
James G. Voelz
OREGON
MAY 4 1966
JAMES G. VOELZ
381

69-1972

69-72