

5/8" x 30" Steel Rod set

Scale: 1"=50'

Date: August 24, 1972


() Data of Record

Bob P Clemens

Rt #2, Box 2375

La Grande, Oregon


Known Mon.

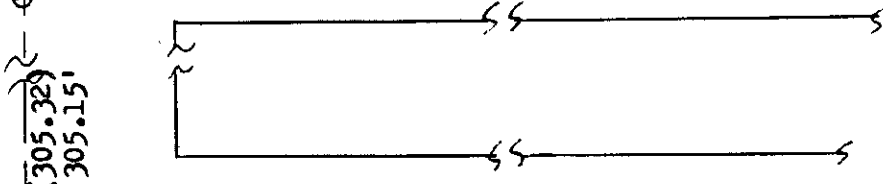


T AVENUE

NORTH FIR STREET

NORTH GREENWOOD STREET

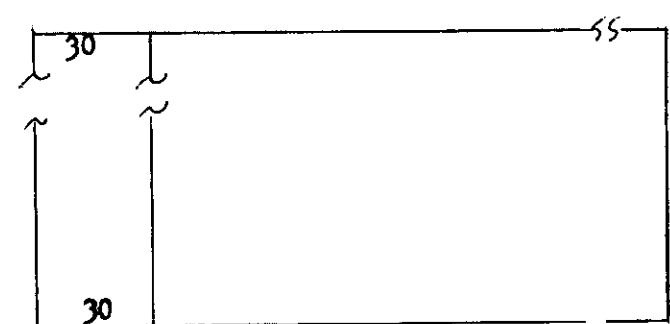

ALLEY

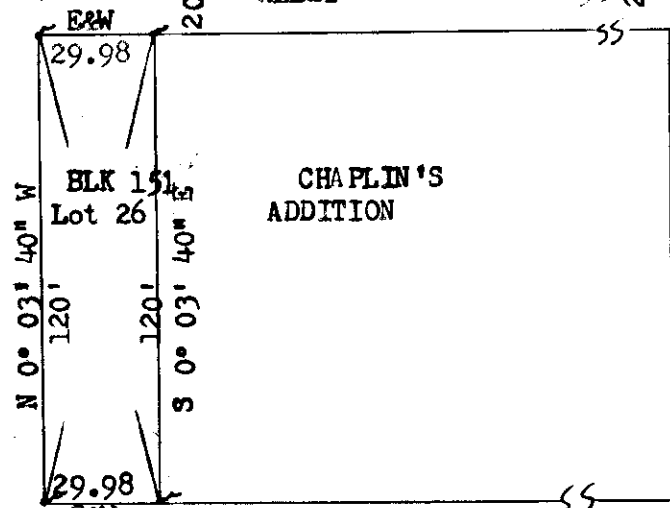

S AVENUE

Known Mon.

Known Mon.

Basis of Bearing E & W

MORRIS AVENUE

REGISTERED PROFESSIONAL LAND SURVEYOR

JAMES G. VOELZ 381

73-1972

73-72