
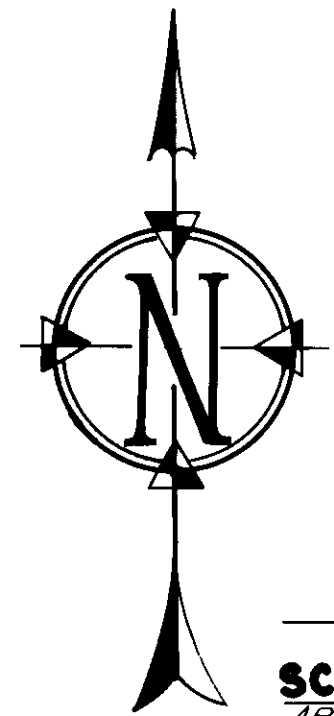


MT. EMILY ACRES

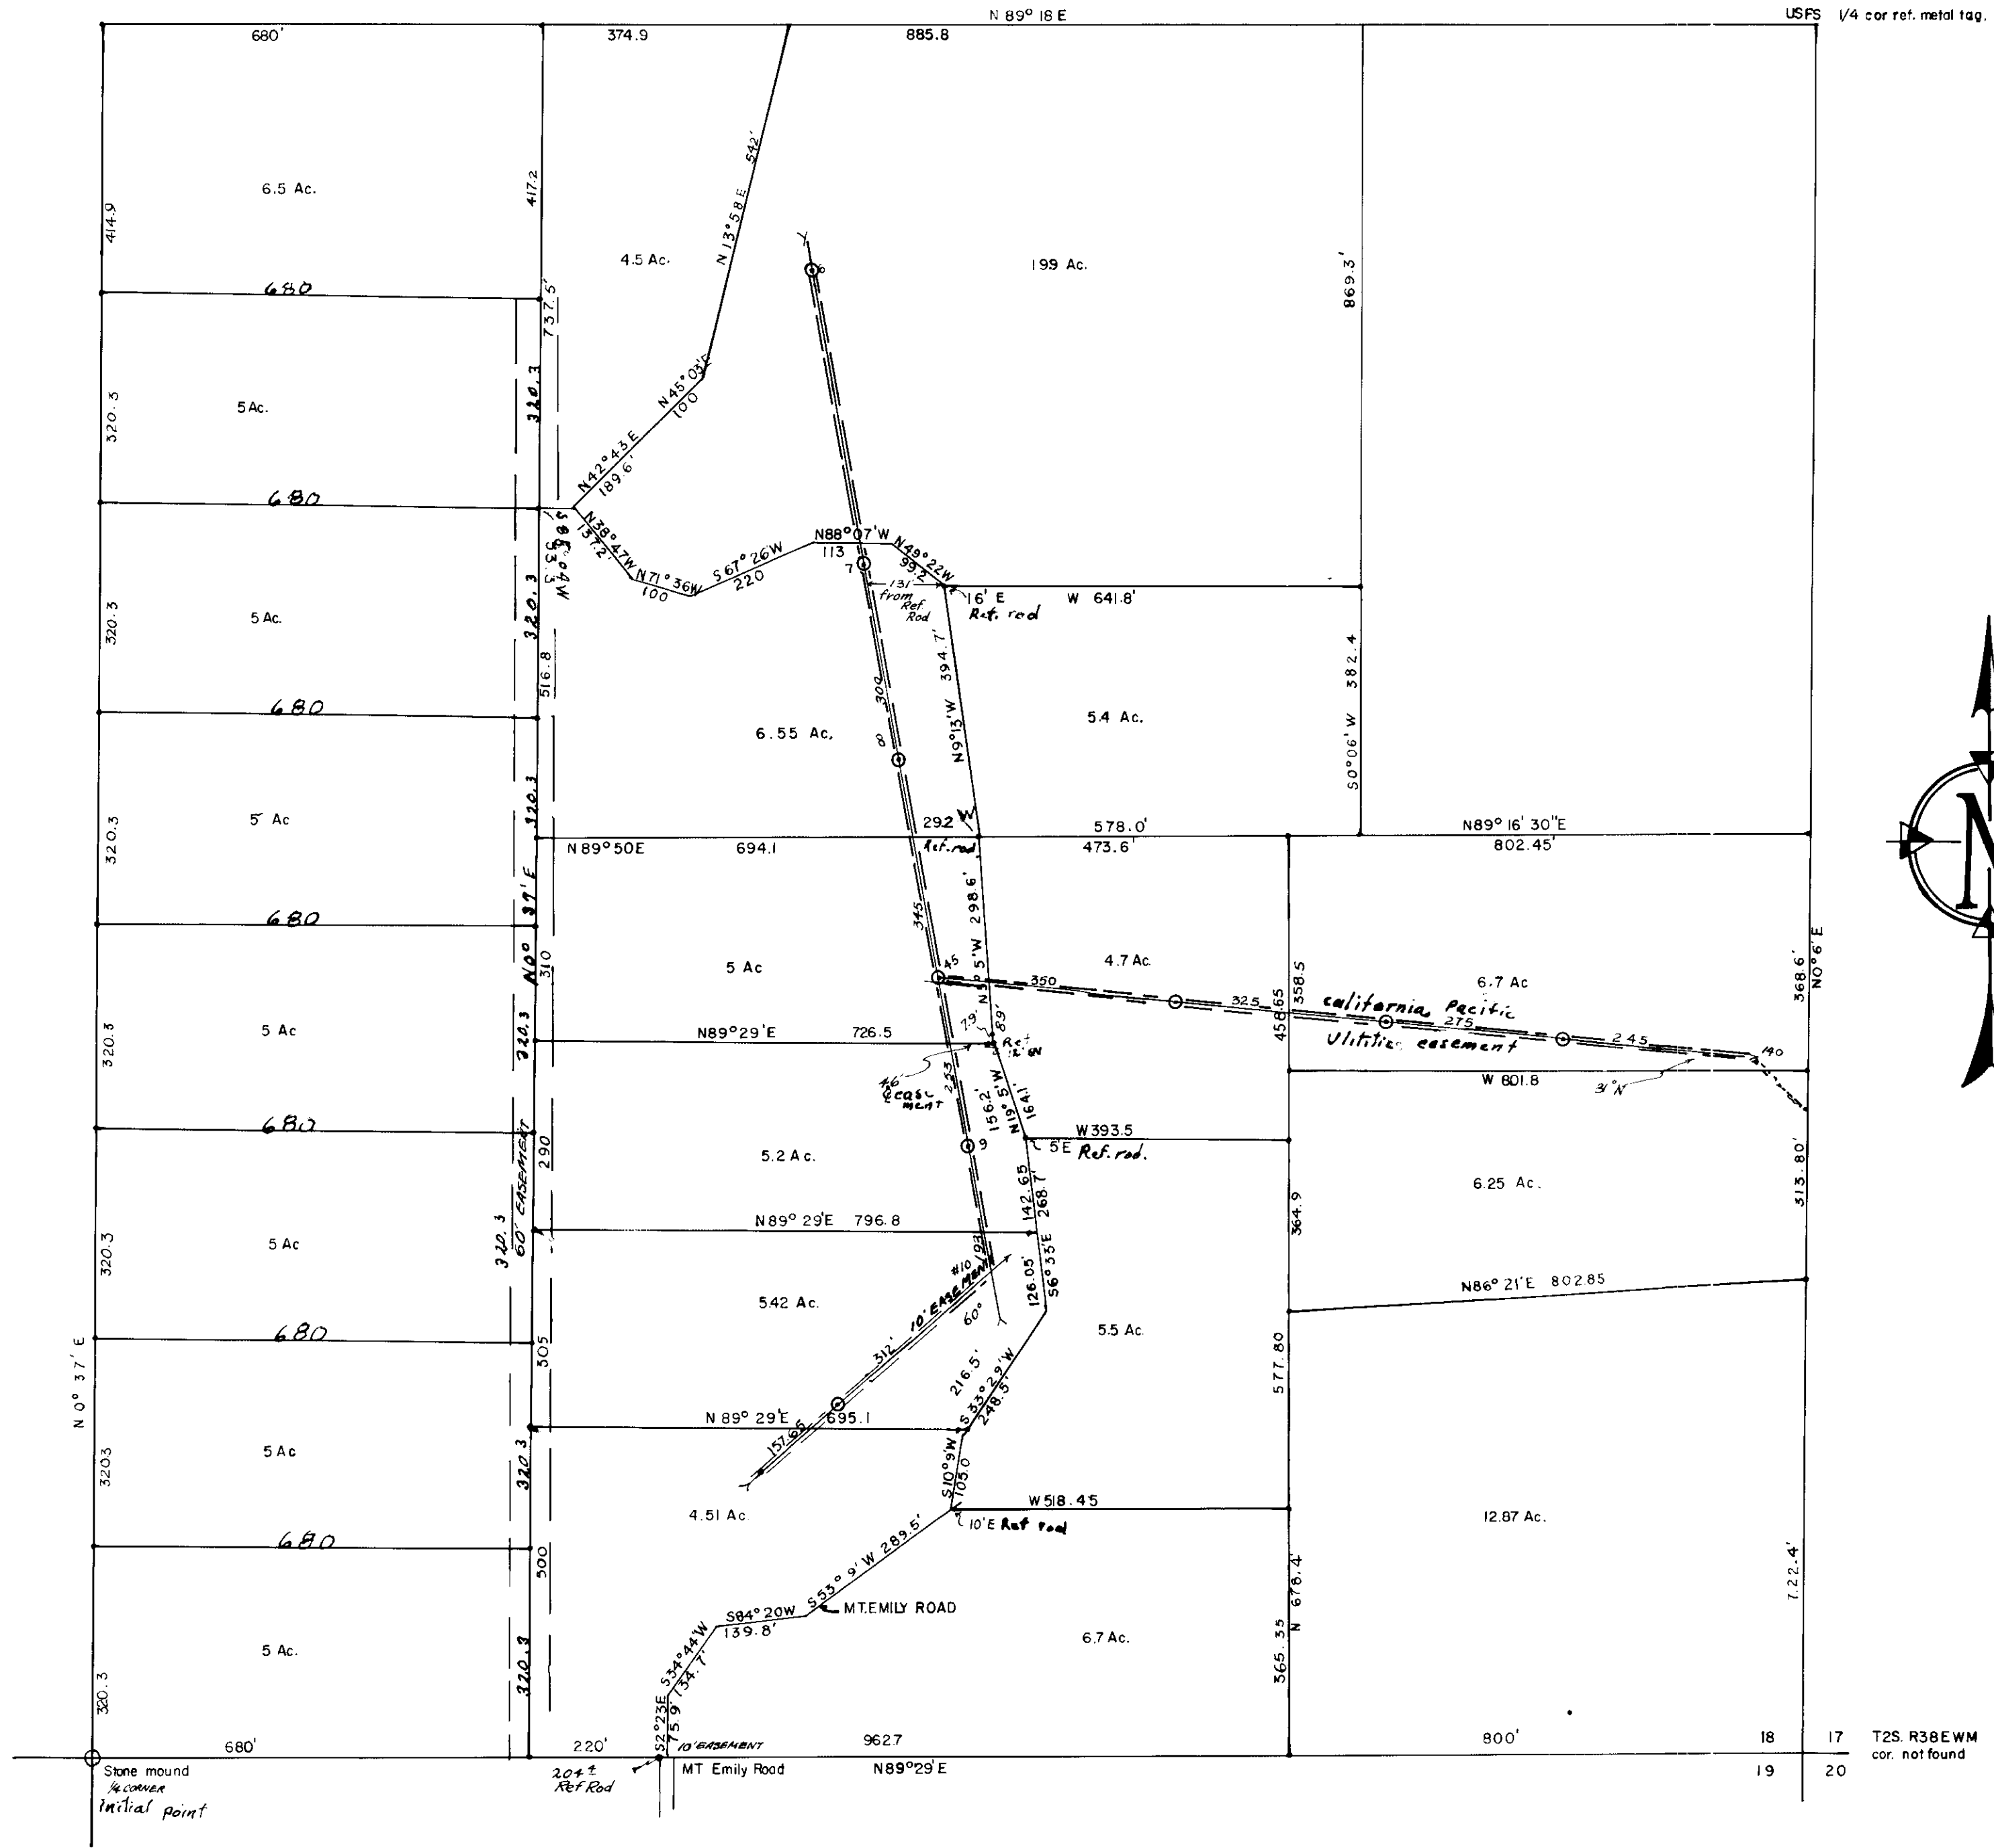

scale 1" = 200'
 APRIL 1971
 Sept. 1972.

• indicates 5/8" steel rod
 ⊙ power poles

REGISTERED
 PROFESSIONAL
 LAND SURVEYOR
James R. Raby
 1971
 1972

30 | 29 cor mon
 31 | 32
 Basis of
 N-S Bearing
 South 1/16 cor conc mon

75.72