


E. A. PETERS
 Island City, Oregon
 September 15, 1972

Scale 1" = 100'

- Set 5/8" x 30" Steel Rod
- () Data of Record
- Found Mon. as indicated
- x-x- existing fence line

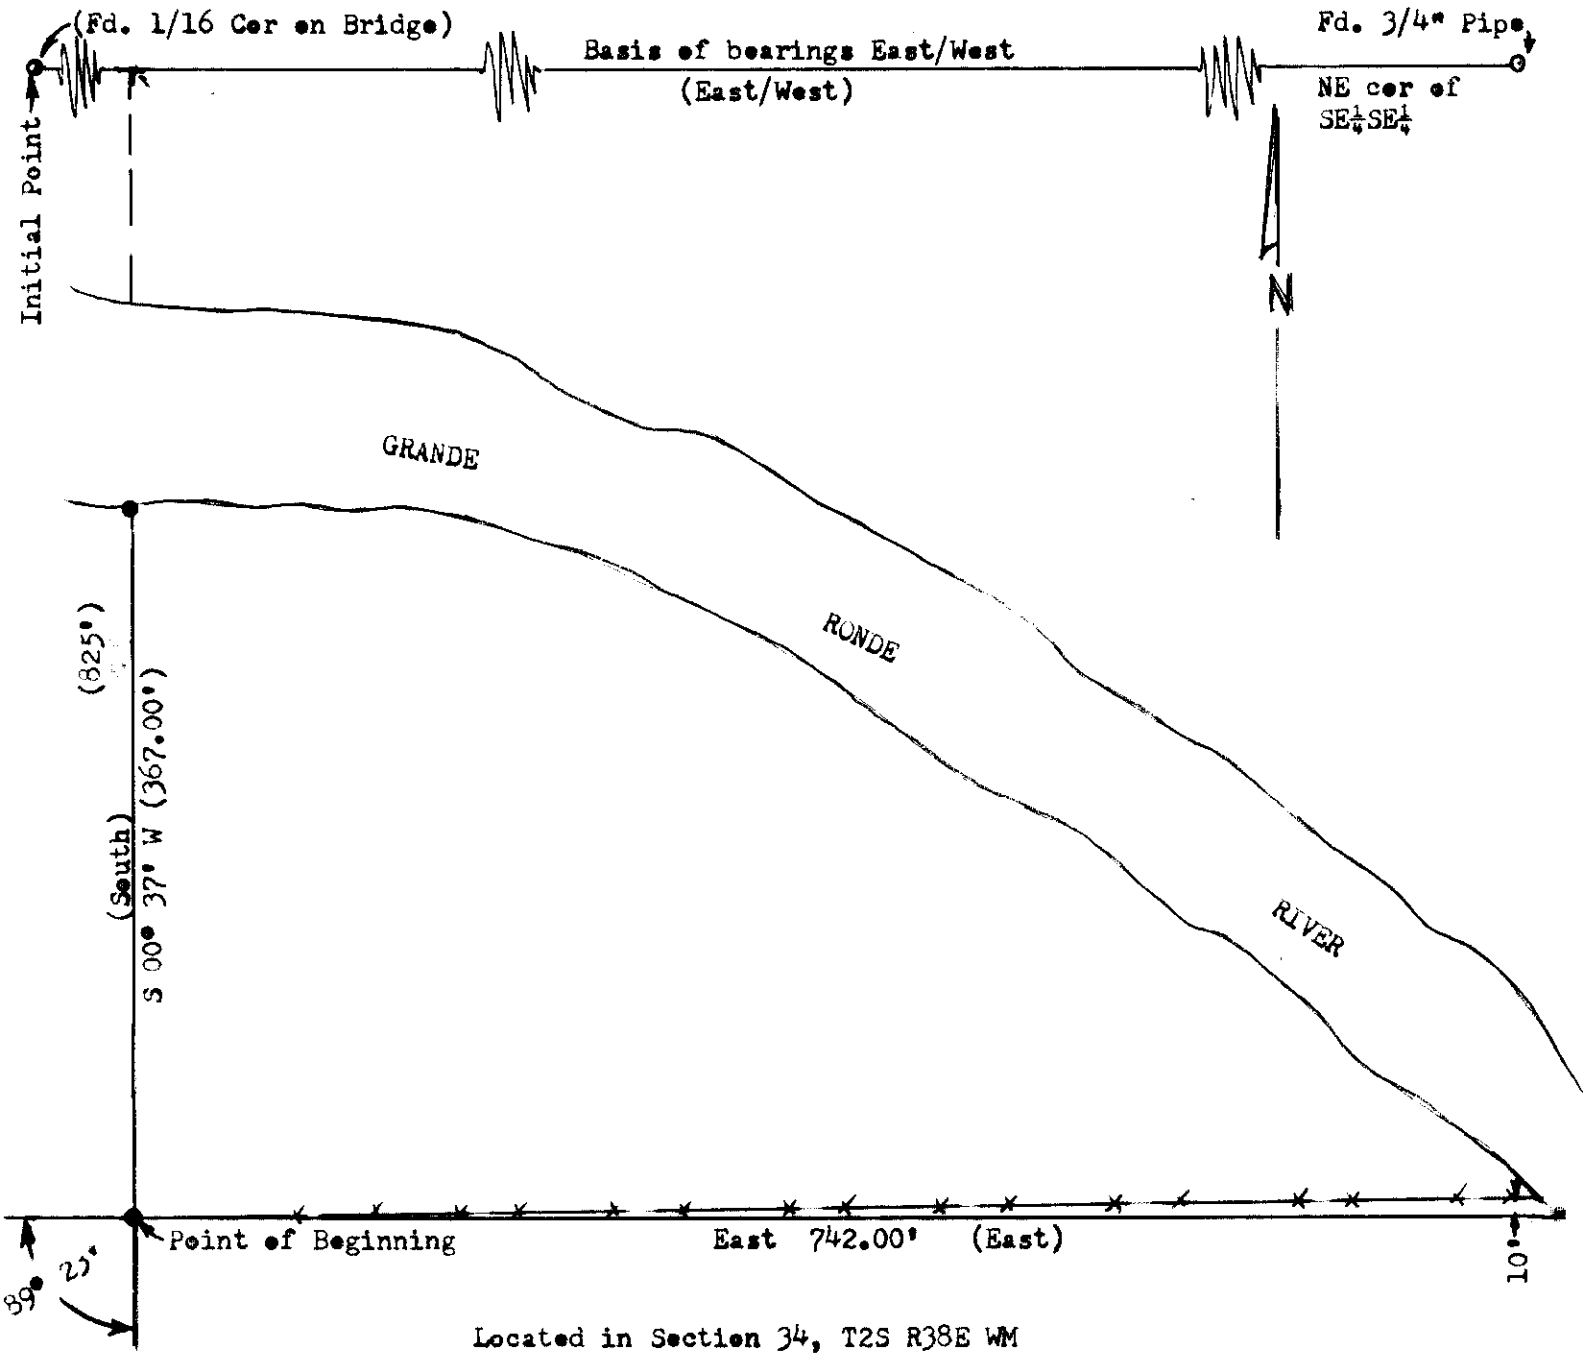

fd. 5/8" rod
 east line SE 1/4 SE 1/4

REGISTERED
 PROFESSIONAL
 AND SURVEYOR

E. A. Peters

OREGON
 1954
 1981

78-72

78-72