


Ed Griggs
P.O. Box 365
Union, Oregon

Scale 1" = 50'

- Set 5/8" X 30" Steel Rod
- Found Monument as indicated
- () Data of Record

October 6, 1972

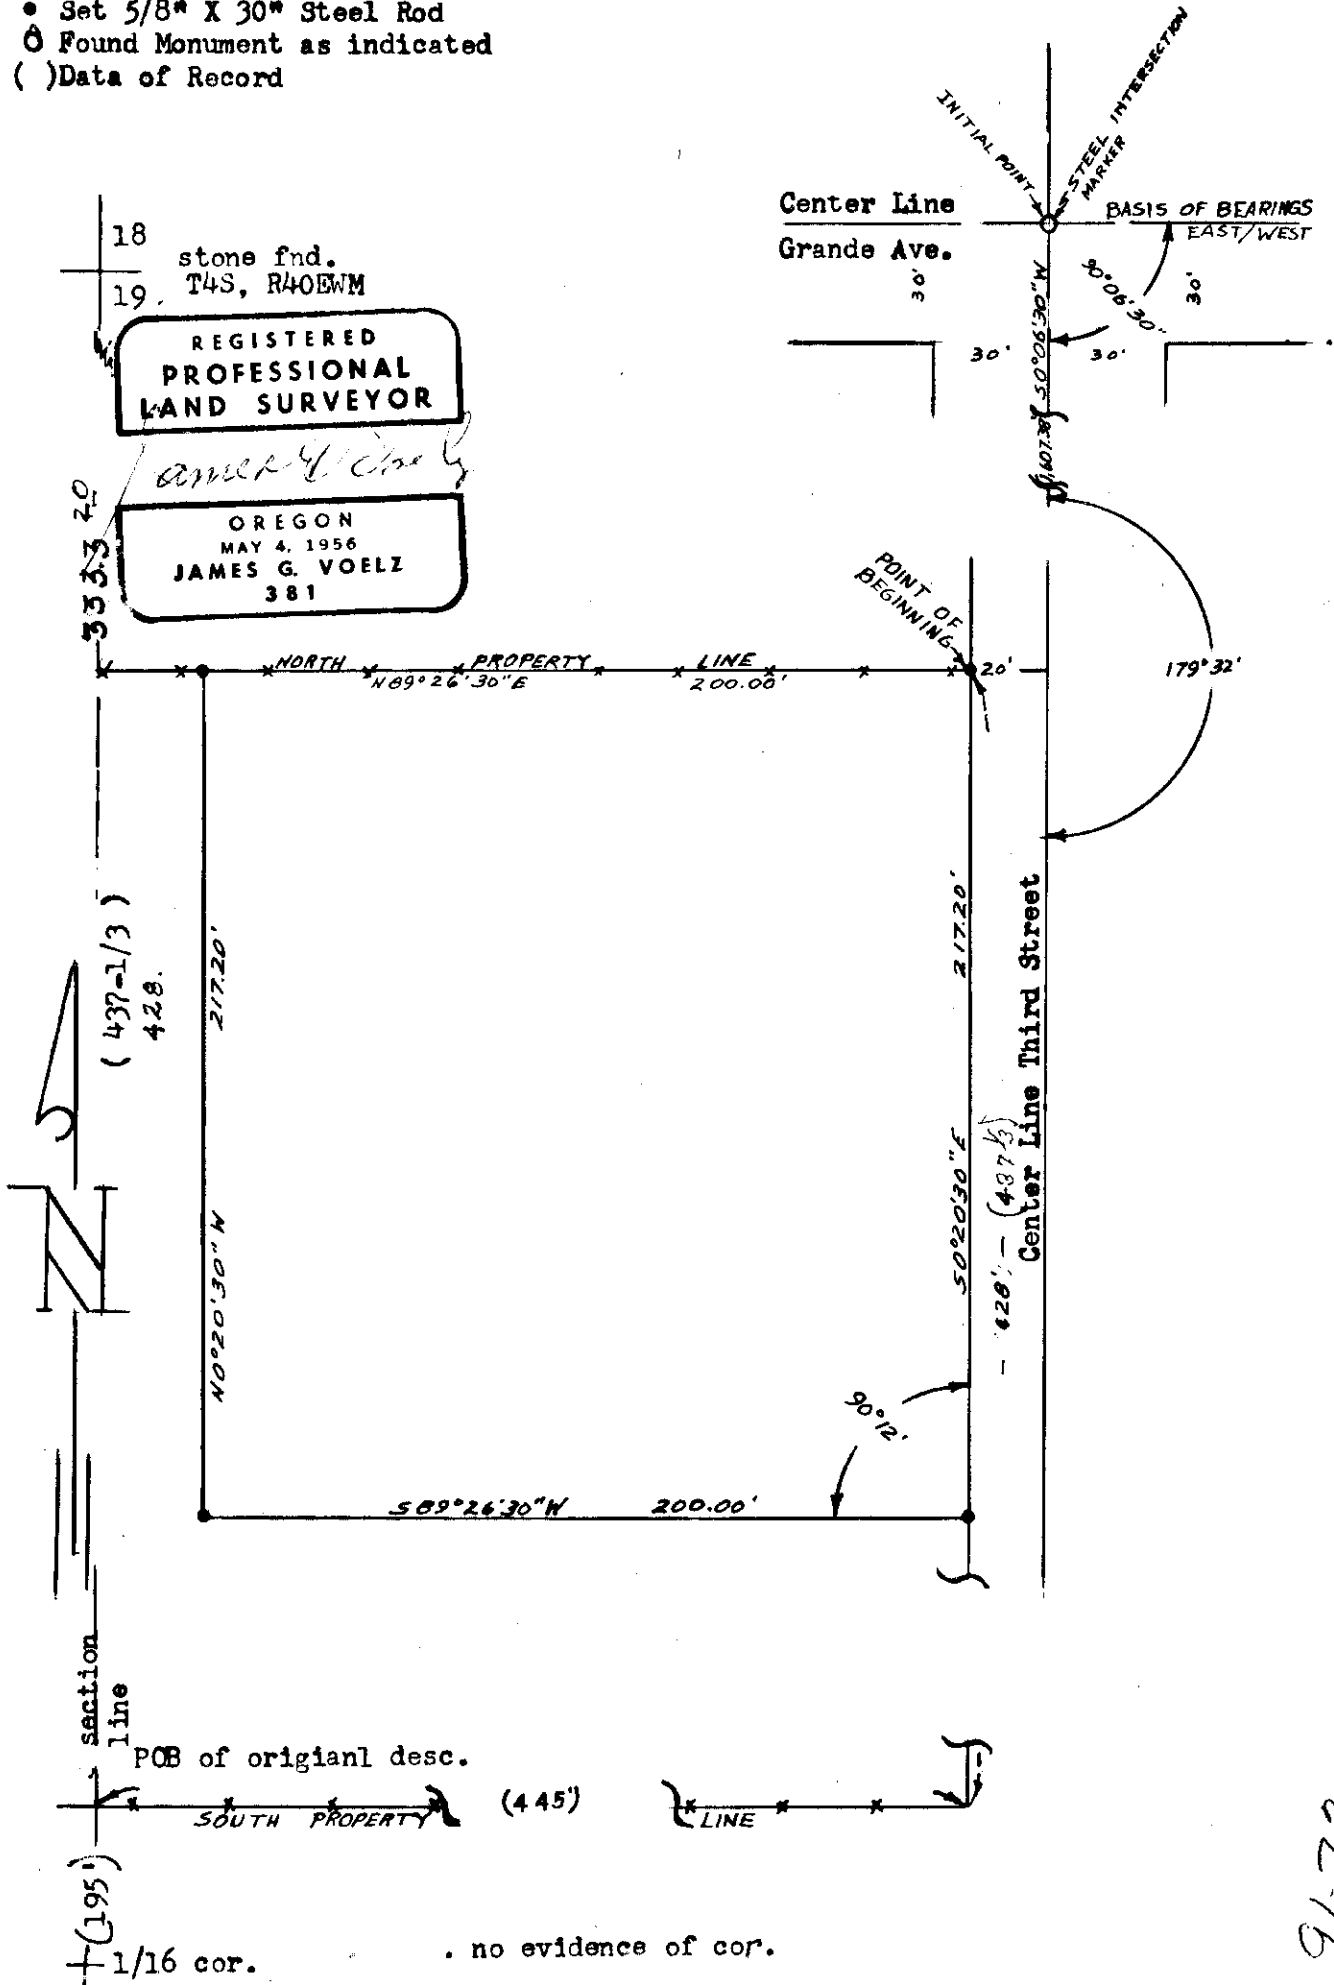

91-72

91-72

. no evidence of cor.