


Ken Burris  
&  
M. Gibbons  
Route 1  
Cove, Oregon

October 10, 1972

Scale: 1"=100'

- Set 5/8" X 30" Steel Rods
- ( ) Data of Record
- Δ Found Angle Iron In Concrete

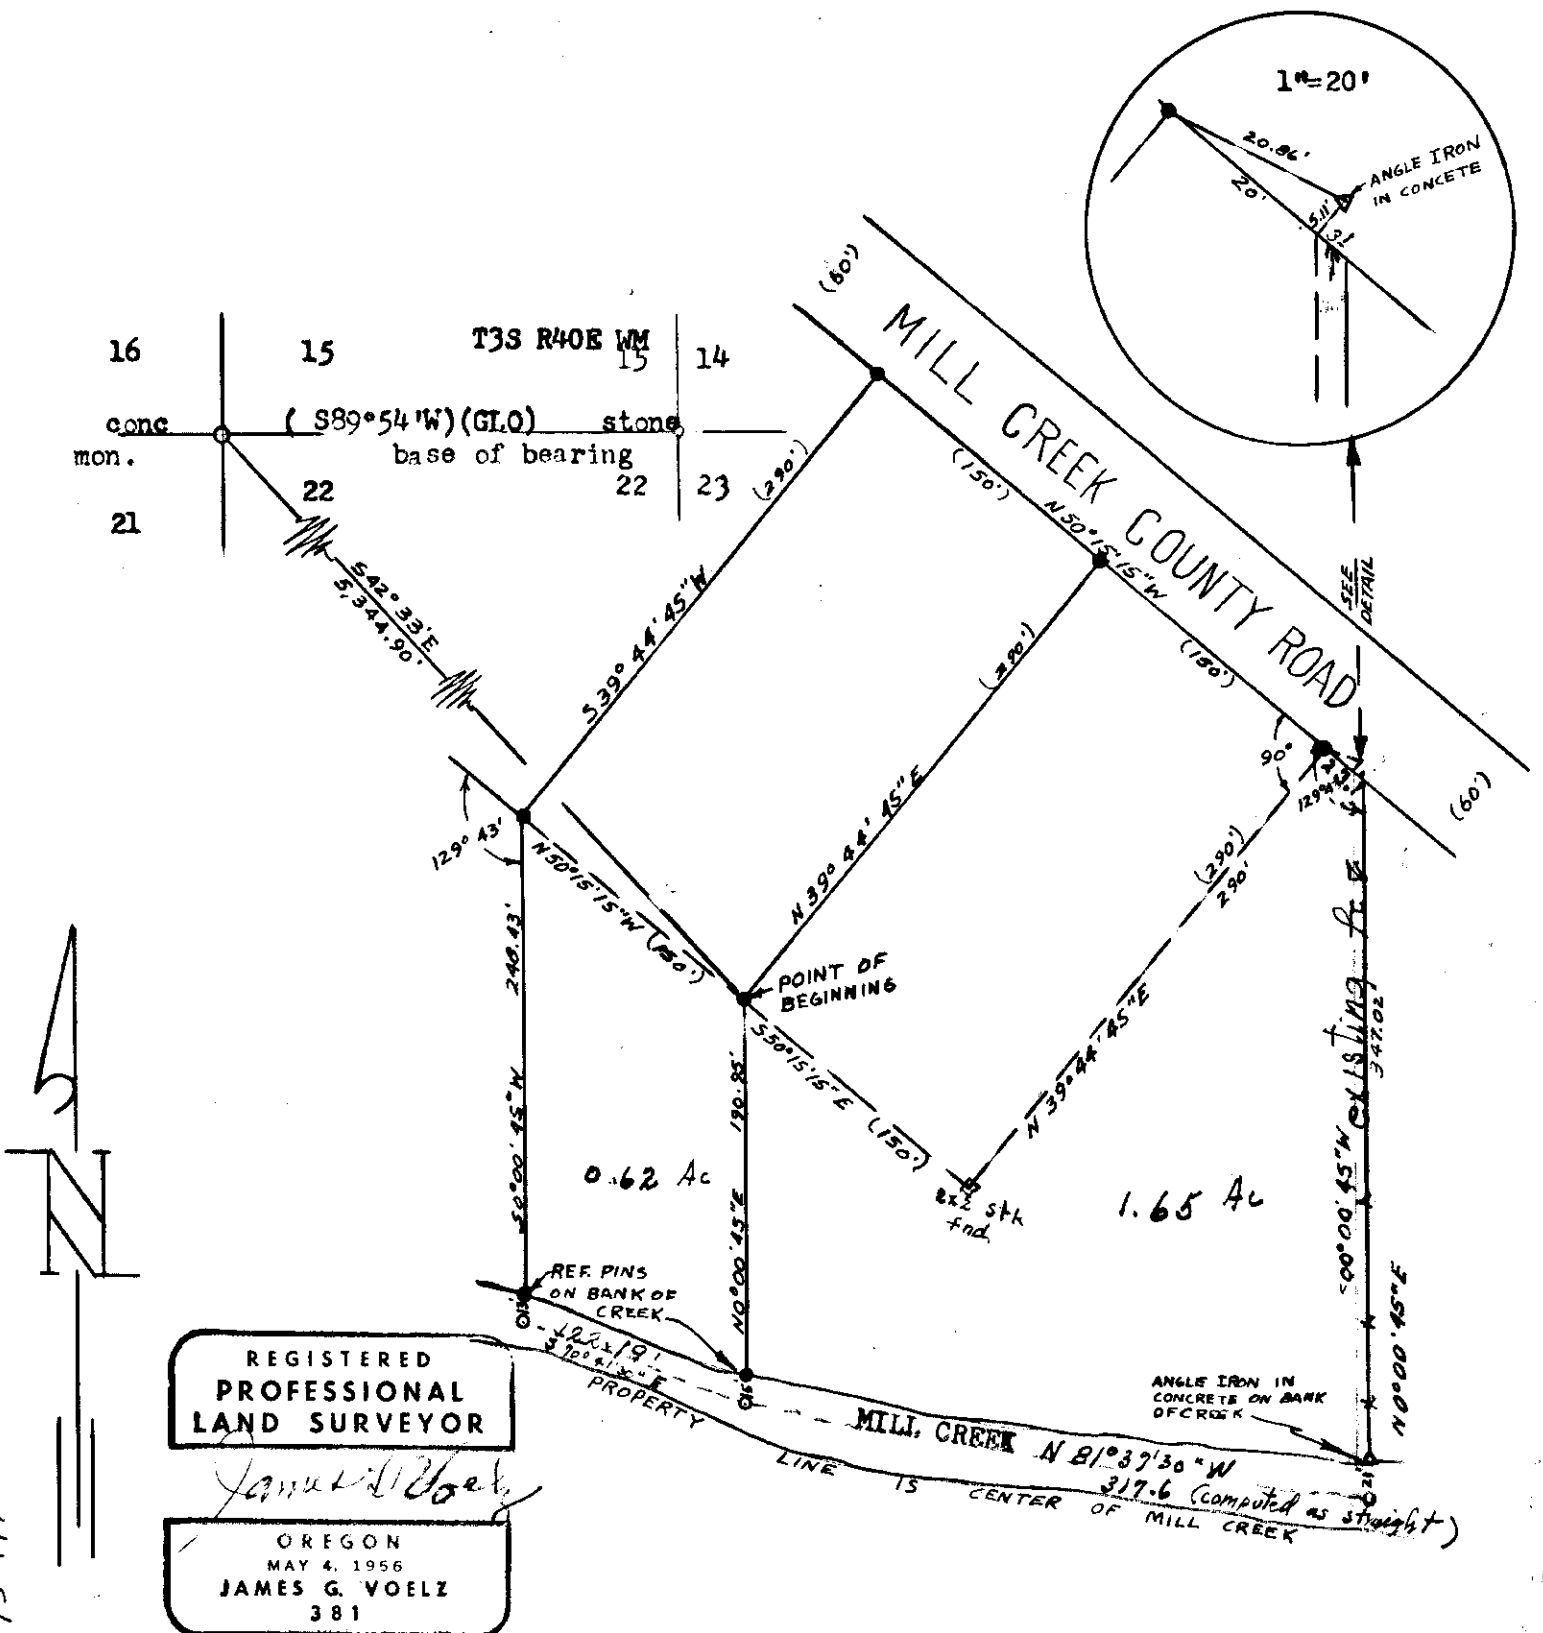

93-1972