

Cecil Johnson  
2704 N. 2nd Street  
La Grande, Oregon

October 29, 1972

Scale: 1" = 60'


- ( ) Data of Record
- o Found Monuments as indicated
- Set 5/8" X 30" Steel Rods

REGISTERED  
PROFESSIONAL  
LAND SURVEYOR

*James G. Voelz*

JAMES G. VOELZ  
381

in RIVERSIDE ADDITION to La Grande, Oregon

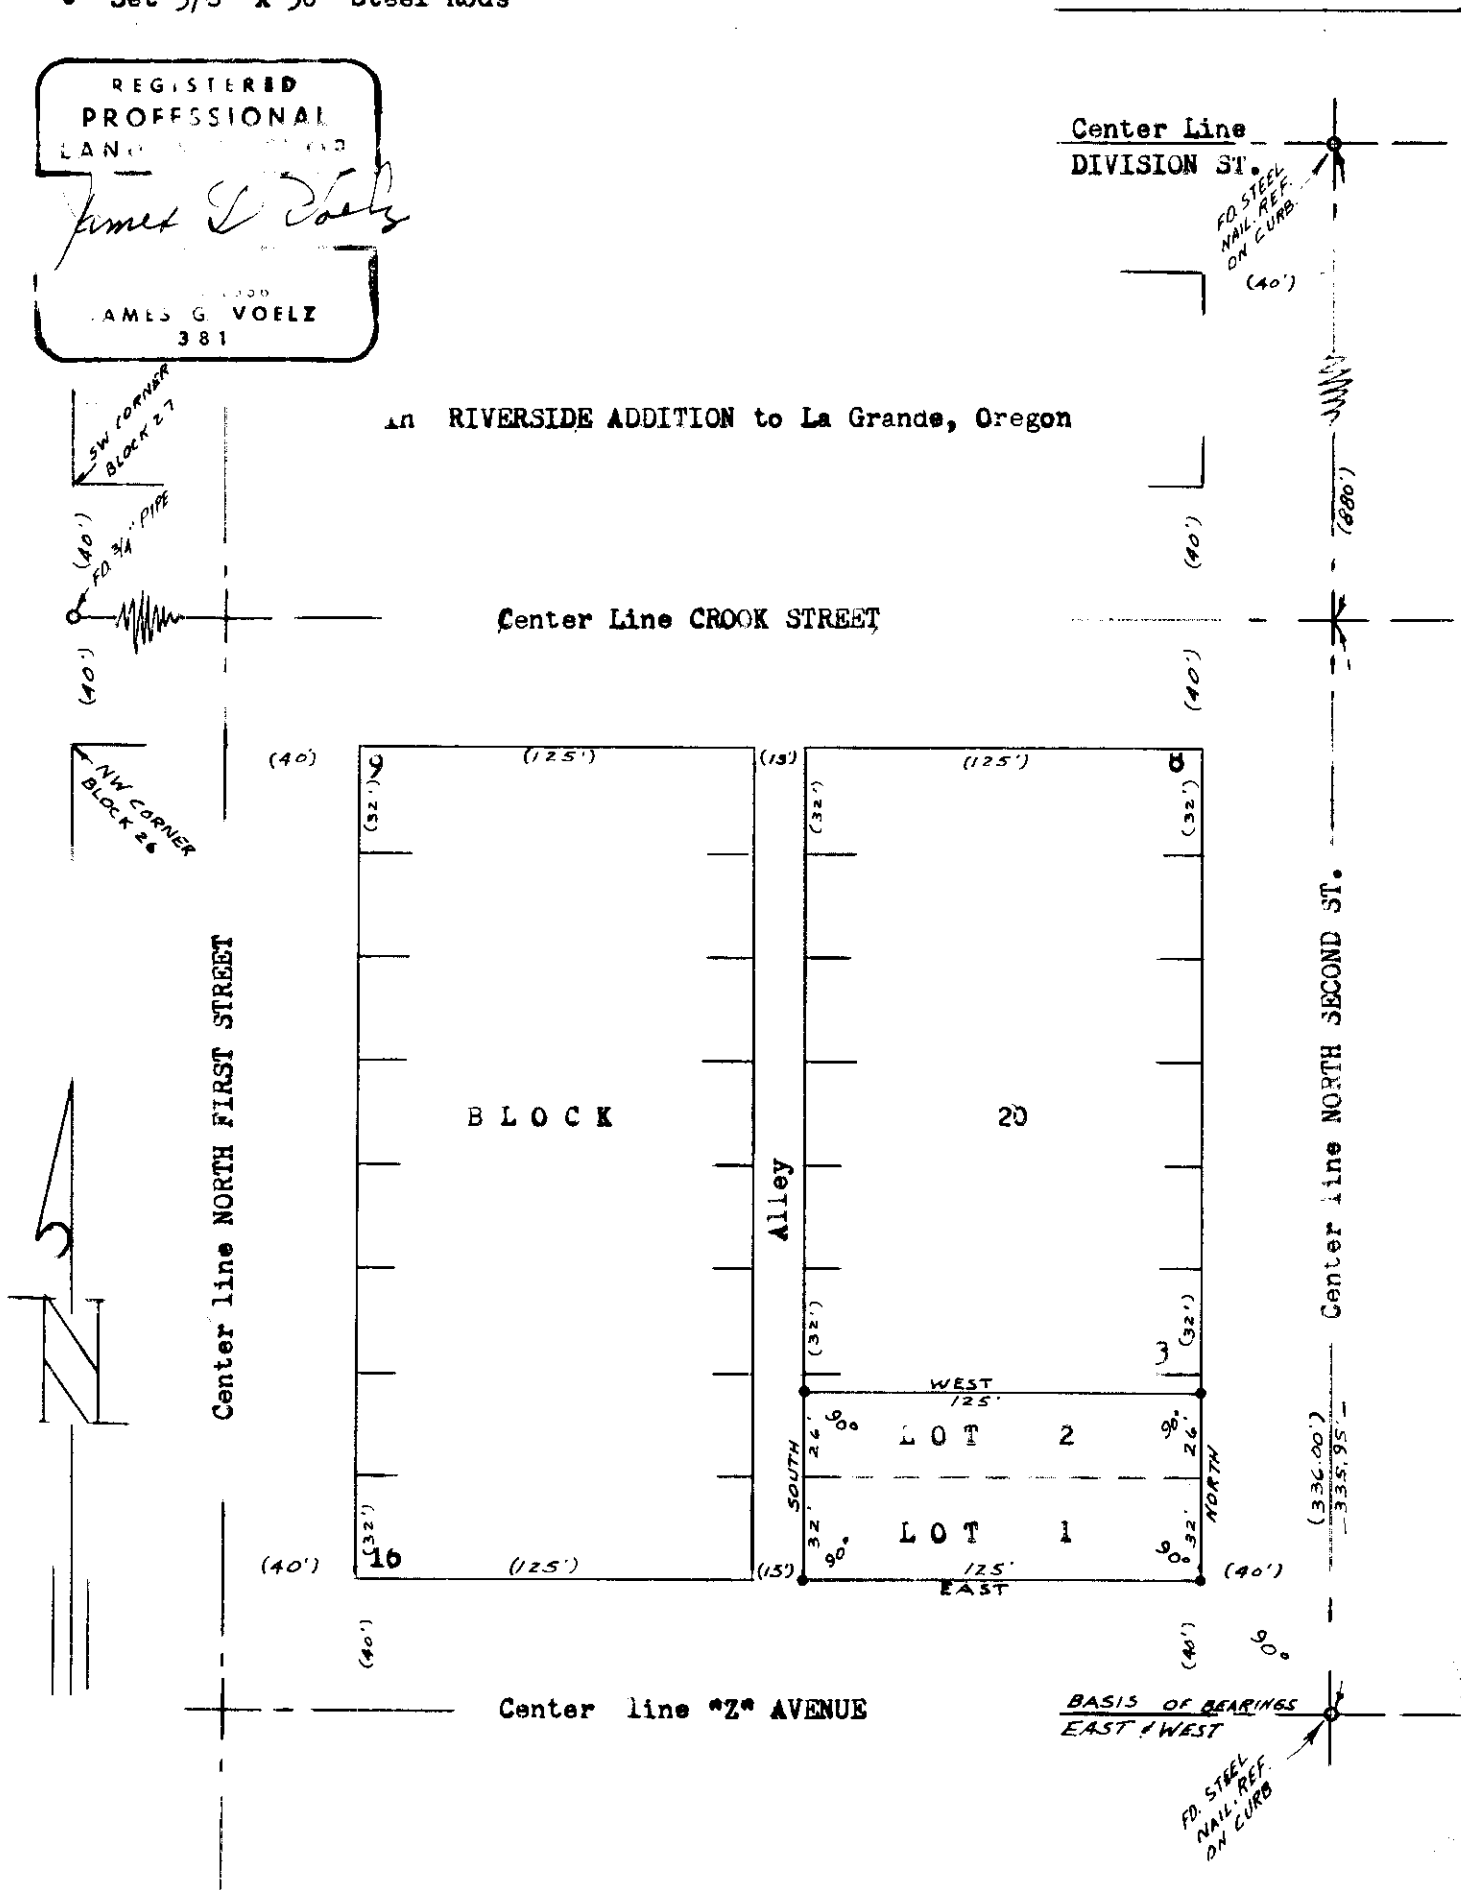

97-1972