


November 7, 1972

Scale: 1" = 40'

- Set 5/8" x 30" Steel Rod
- o Found Monuments as indicated
- () Data of Record
- Centerline of streets

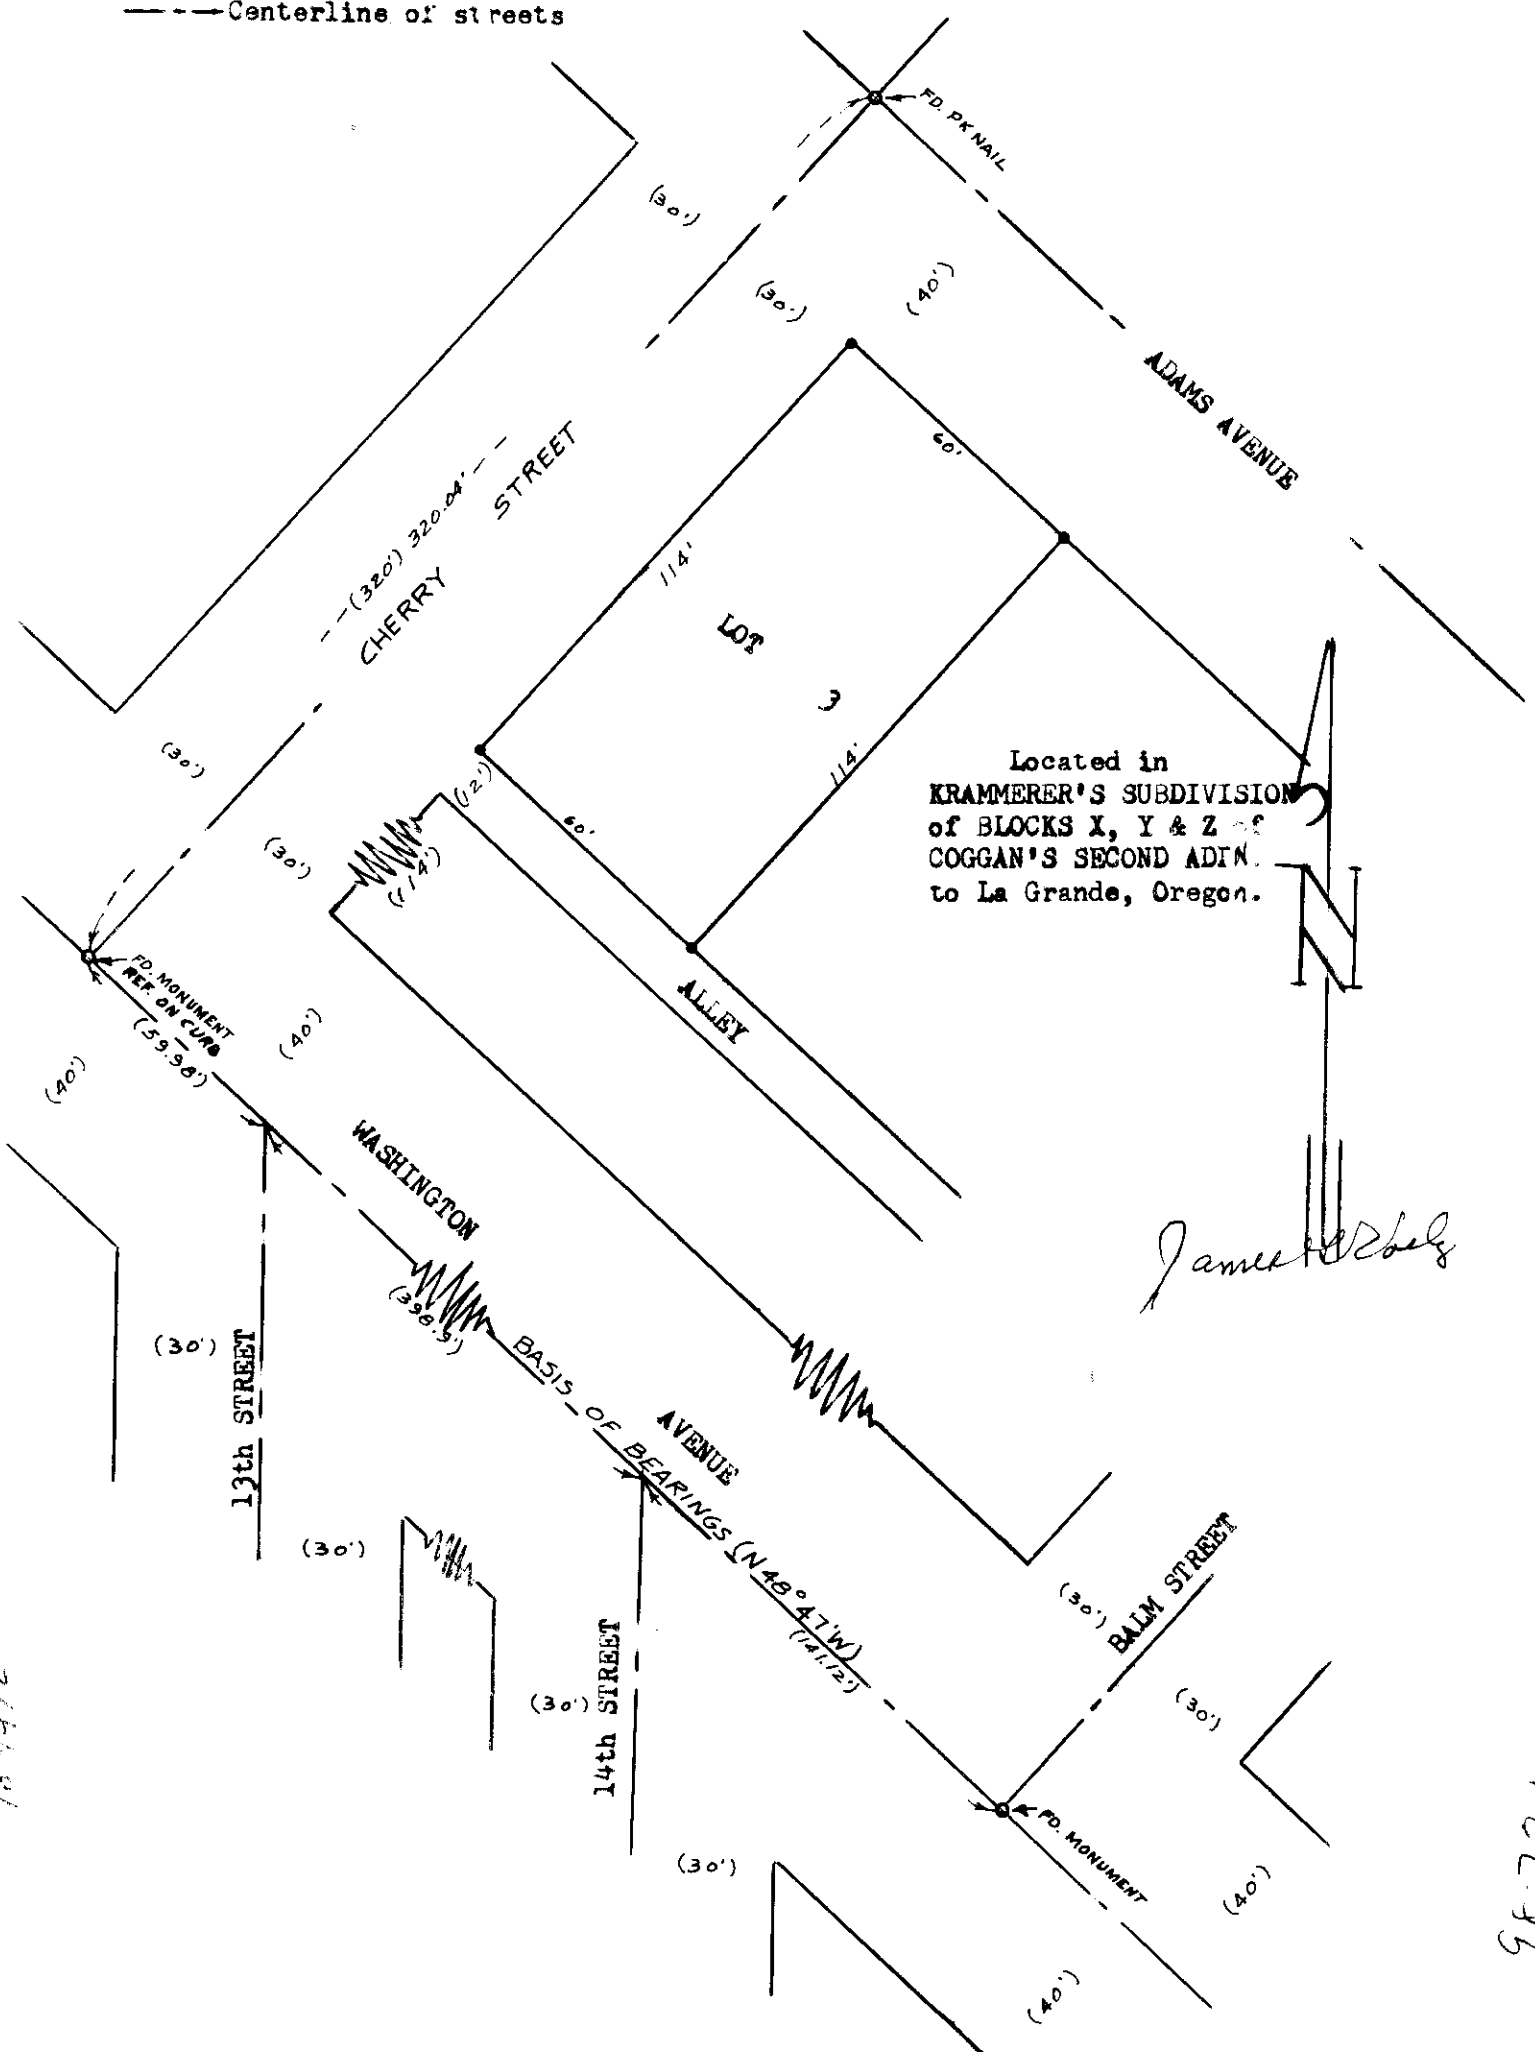

Located in
KRAMMERER'S SUBDIVISION
of BLOCKS X, Y & Z of
COGGAN'S SECOND ADJN.
to La Grande, Oregon.

James E. Debel

98.722

98.722