
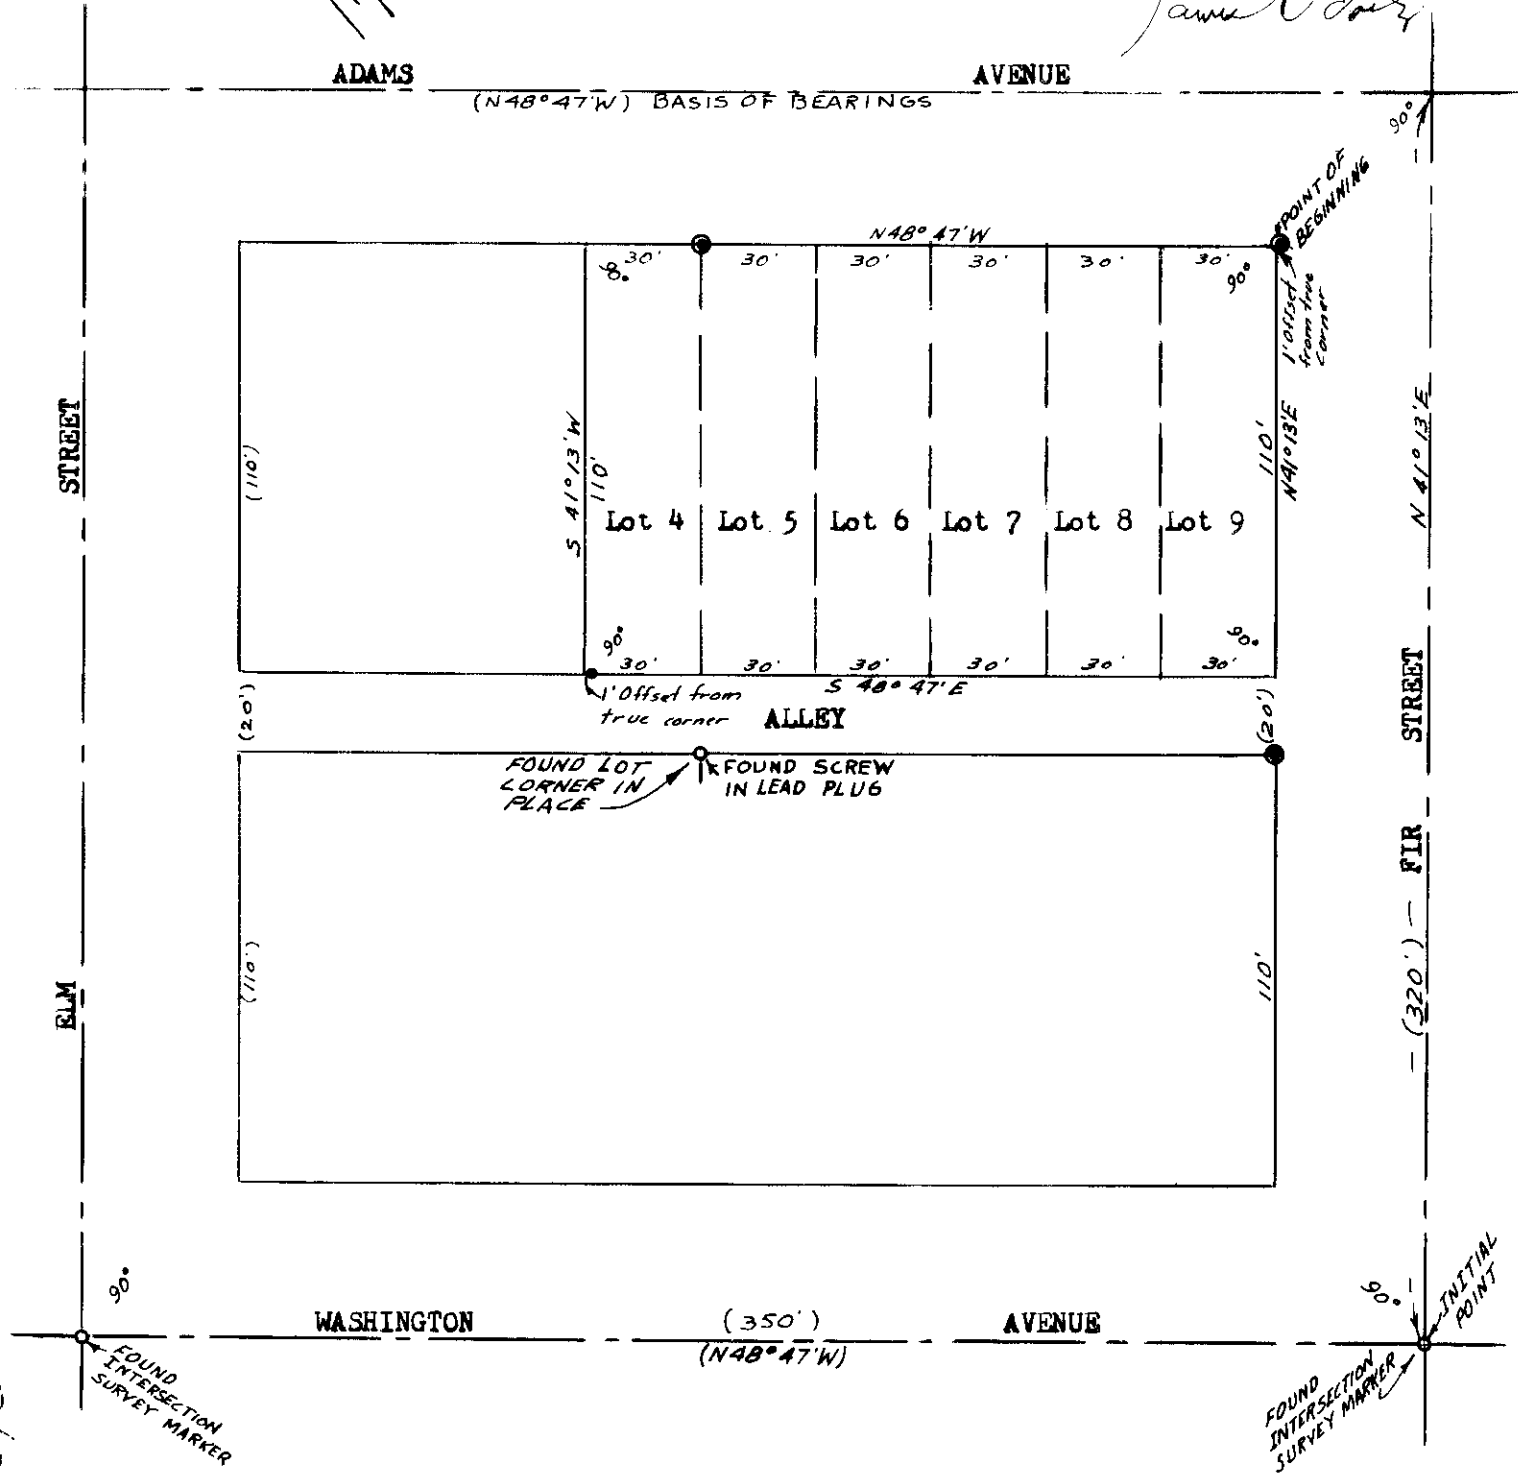


FIRST NATIONAL BANK
of Oregon
La Grande Branch
La Grande, Oregon

November 12, 1971
Scale: 1" = 50'
() Data of Record
• Set 5/8" x 30" steel Rod
● Set screw in lead plug
○ Found Monuments as indicated
--- Street center line

Block 107 CHAPLIN'S ADDN.

James W. Day

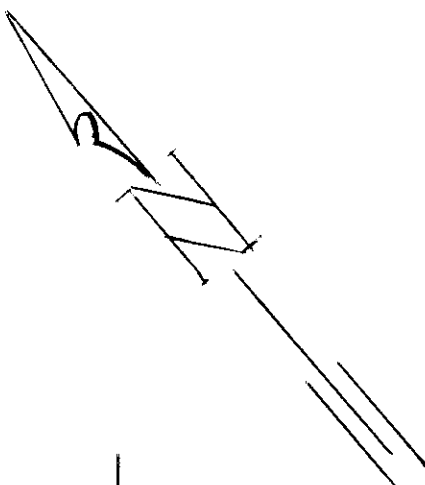

101-1/2-