


MAP OF SURVEY

SHOWING RELATIVE POSITIONS OF VARIOUS MONUMENTS, PROPERTY CORNERS AND GOV'T. CORNERS IN SEC. 3, T. 3 S., R. 38 E., W. M., UNION COUNTY, OREGON

Sept. 14, 1972

Scale 1" = 200'

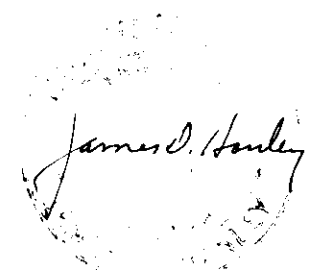

109-72