Survey for
CLAIRE E. McMANUS
November, 1972

LEGEND

( )	*Data of record.*
∘	*Found monuments as indicated.*
•	*Set 5/8" X 30" steel pins.*
—·—	*Center line of County Road.*
Scale	1" = 200'

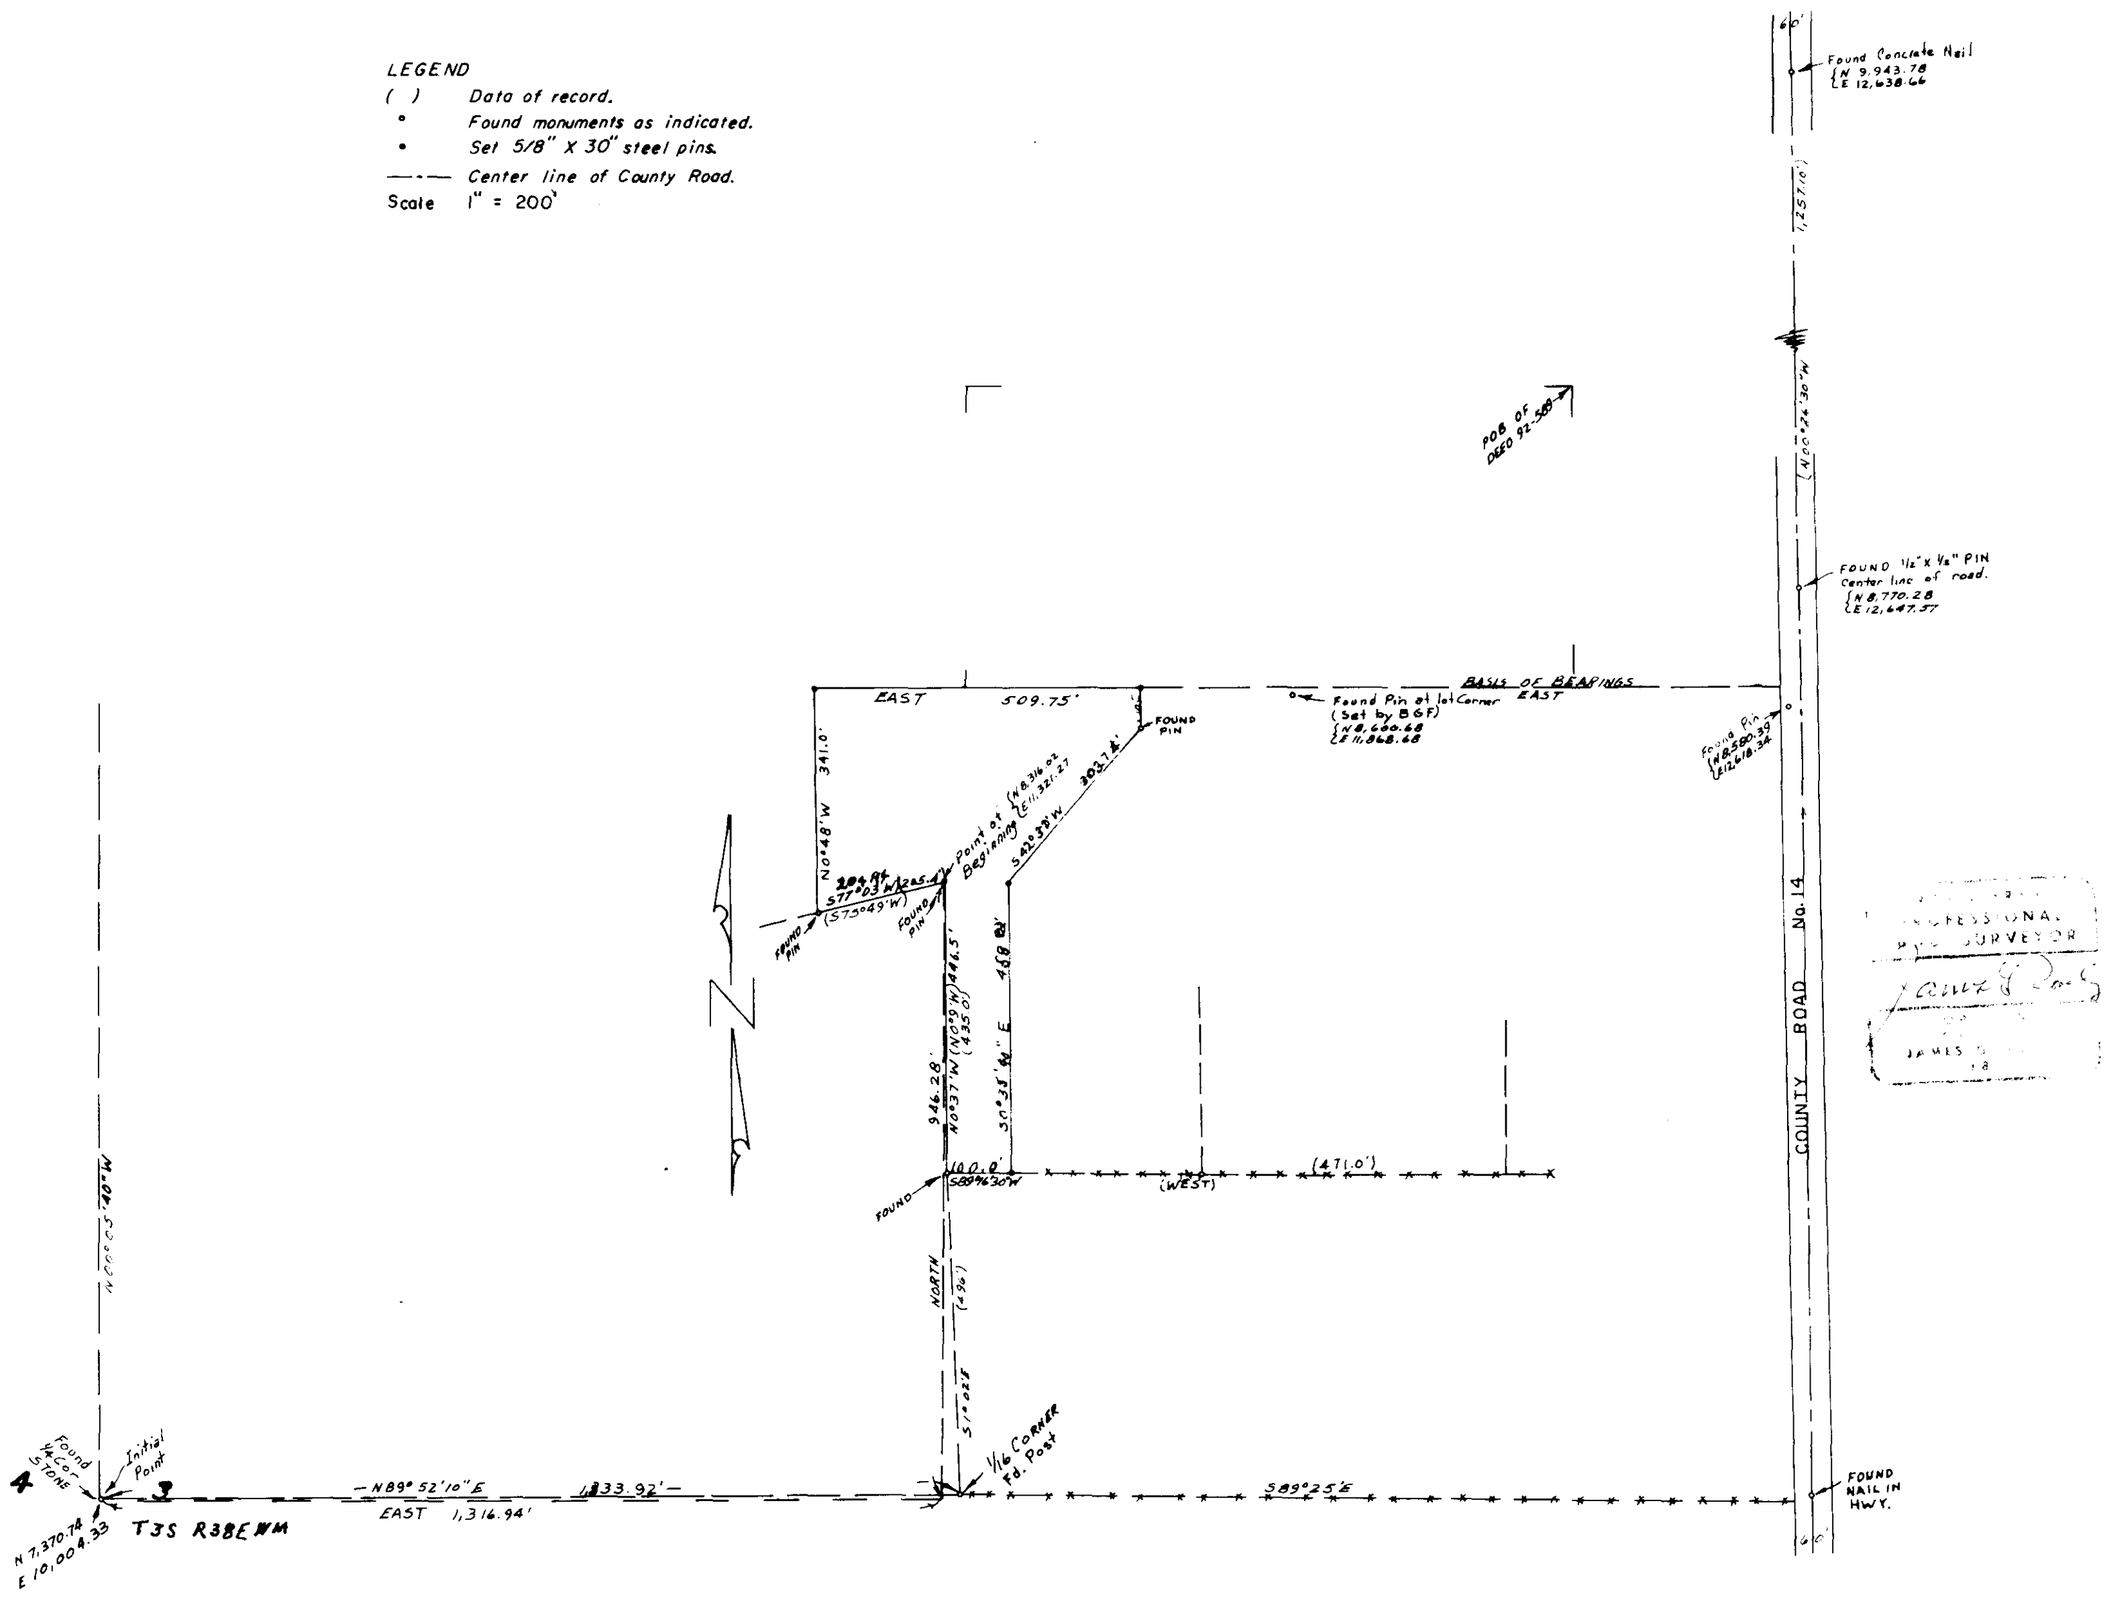

1-73