

Donal R. & Patricia L. Berryhill
 1906 Third Street
 La Grande, Oregon

January 5, 1973


LEGEND

Scale: 1" = 20'

() Data of Record.

- Found monuments as indicated.
- Set 5/8" x 30" steel rods.
- ⊕ Set brass screw in lead plug.
- Center line of streets.

Located in GRANDY'S ADDN, Blk 8
 of La Grande, Oregon

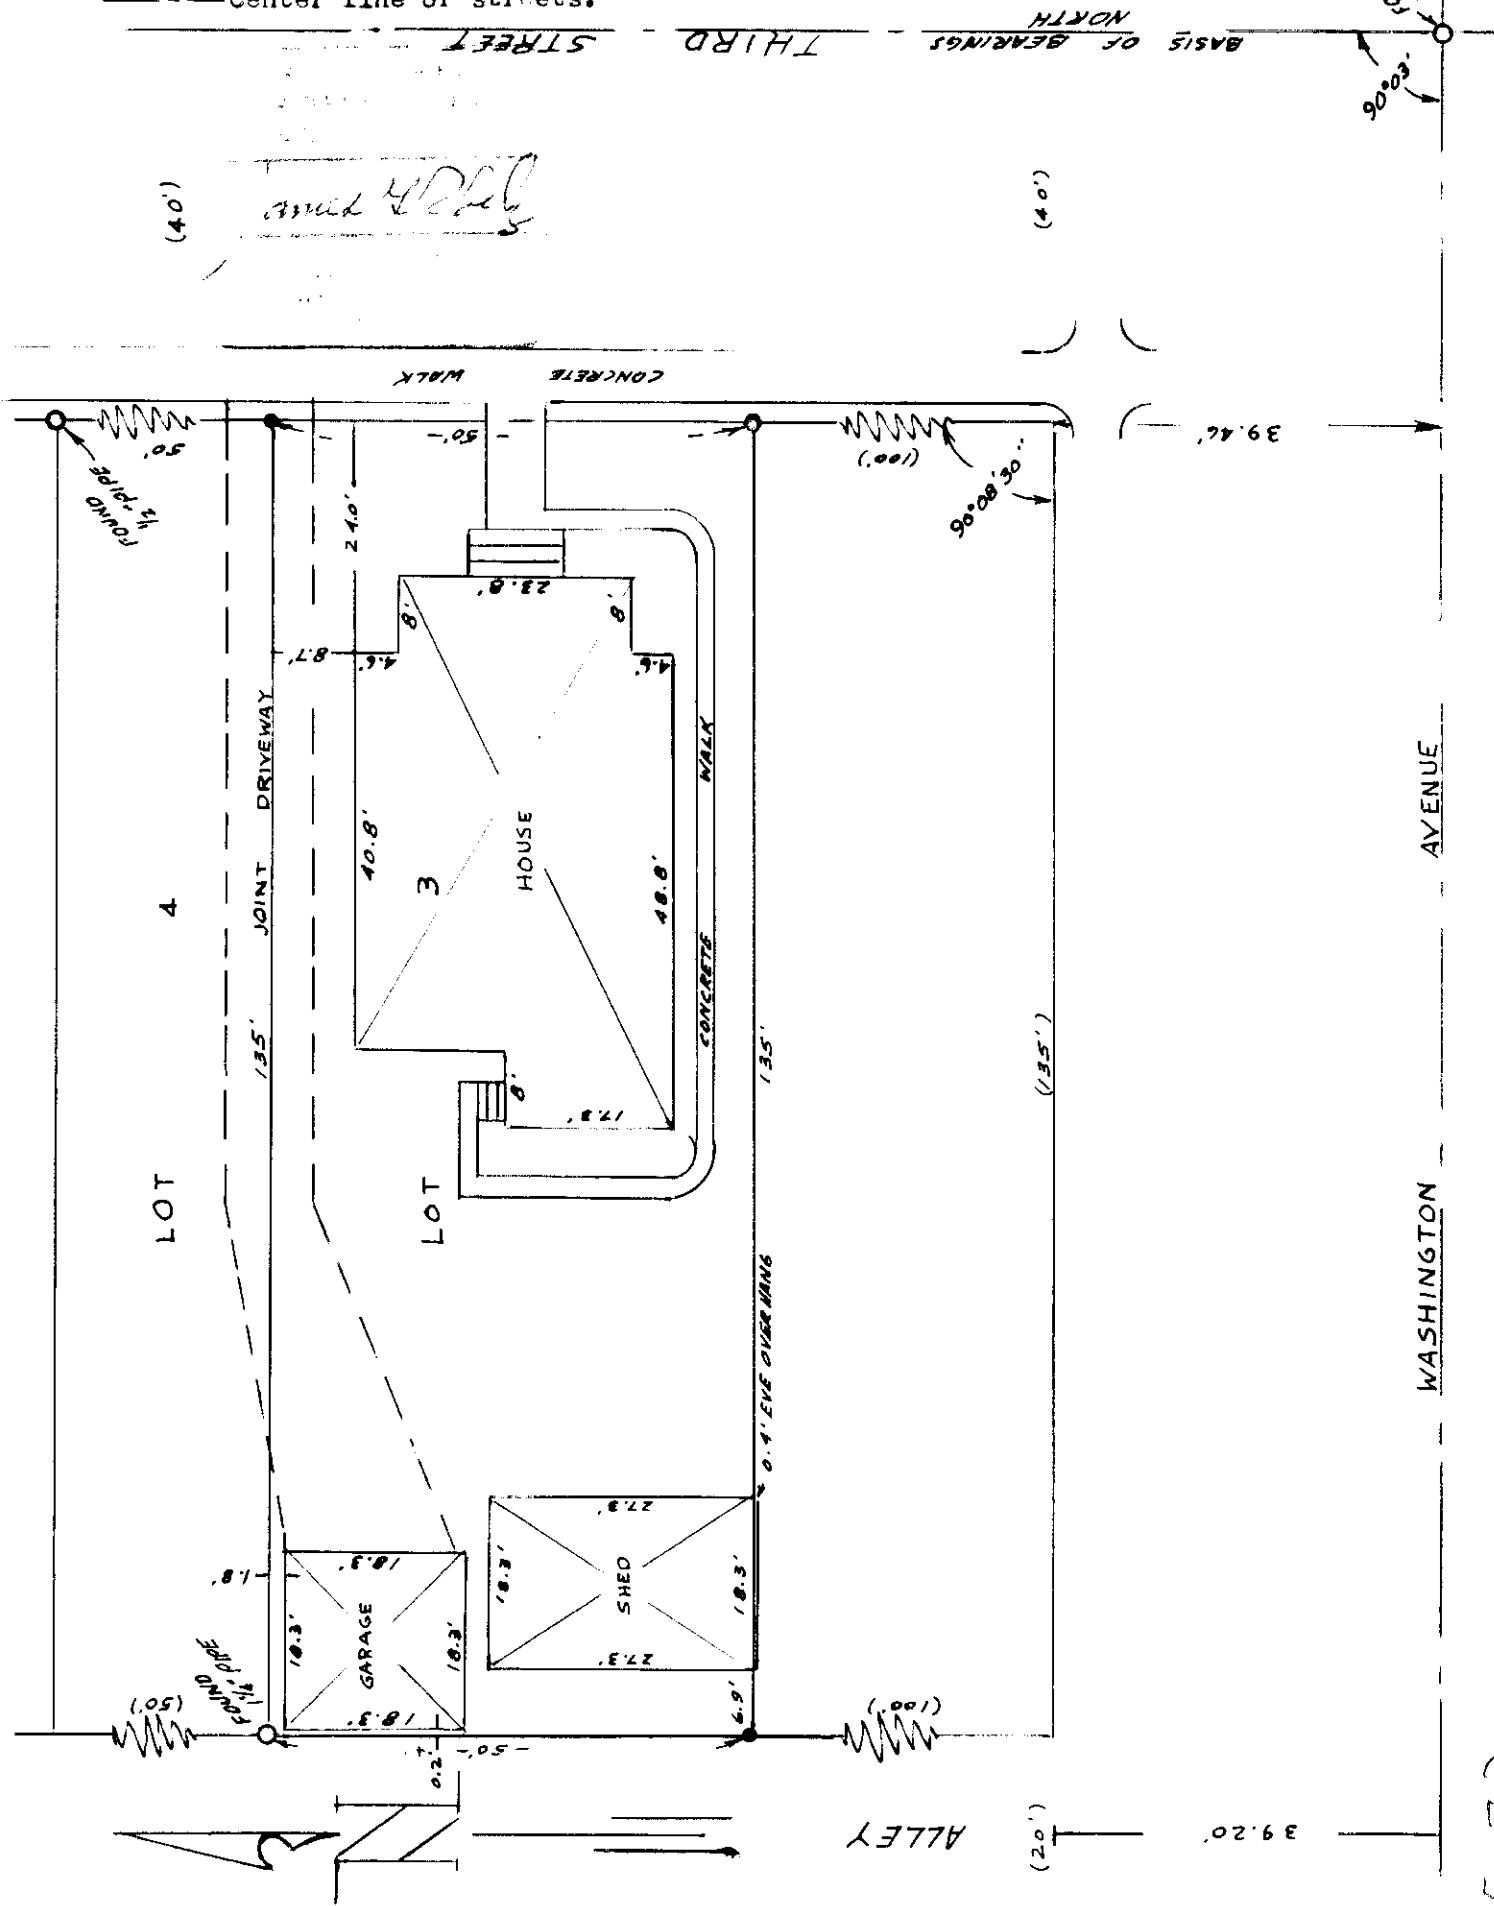

5-73