

Donald R. & Patricia L. Berryhill  
1906 Third Street  
La Grande, Oregon

January 5, 1973

LEGEND

Scale: 1" = 40'

( ) Data of record.

○ Found monuments as indicated.


• Set 5/8" x 30" Steel Rods.

⊙ Set brass screw in lead plug.

--- Center Line of streets.

BLOCK 8, GRANDY'S ADDN.

*James Y. Berry*  
JAMES Y. BERRY

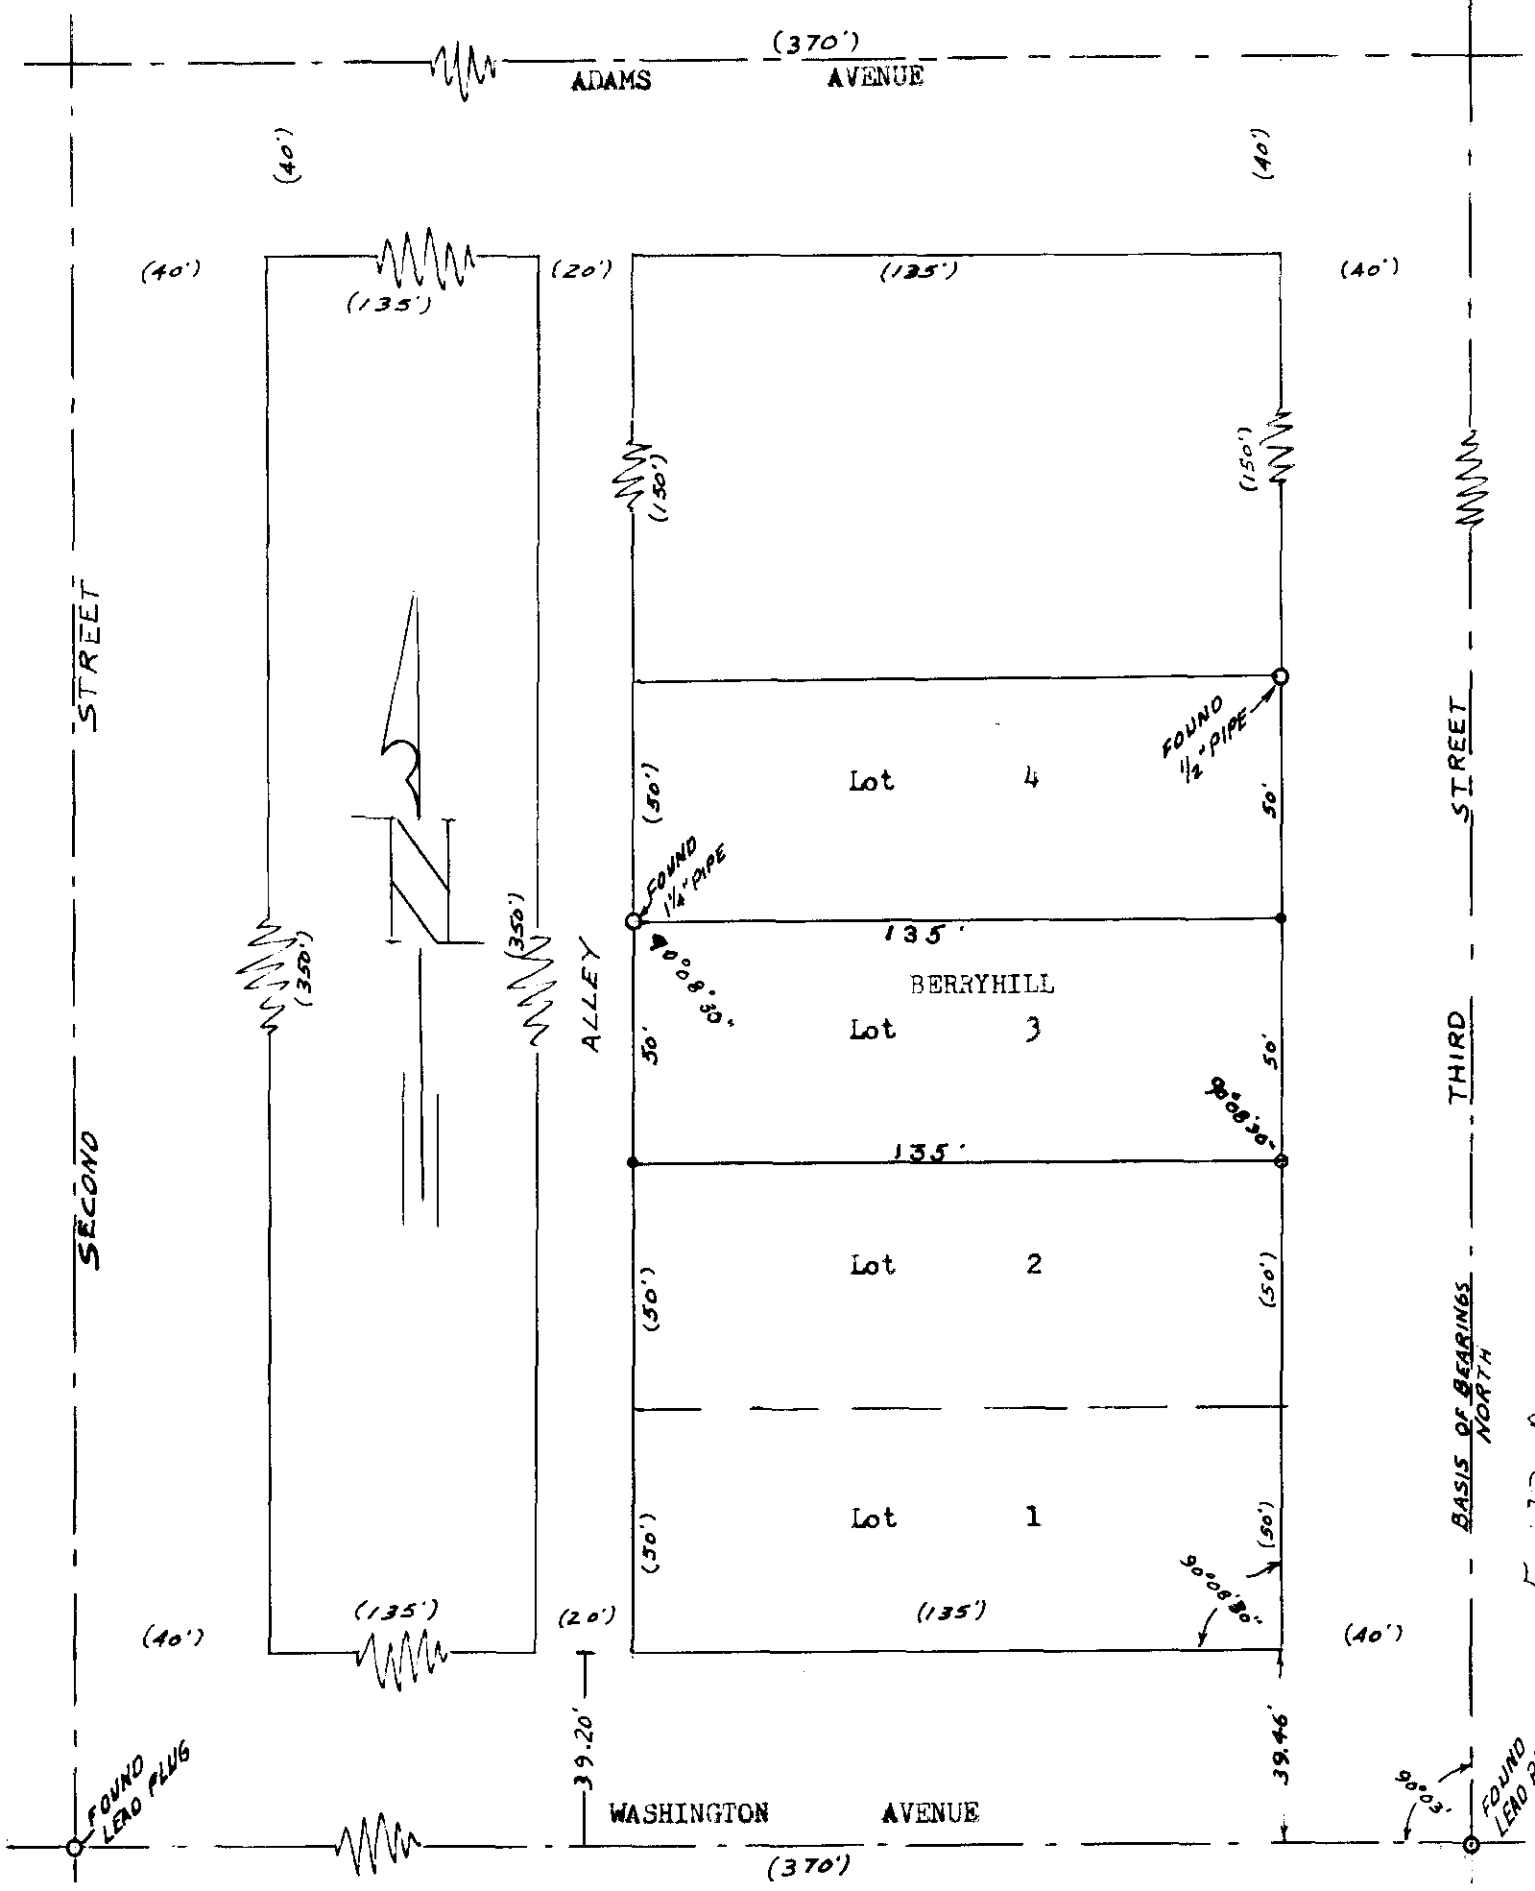

BASIS OF BEARINGS NORTH

5-73-A