G. W. Spence
South 12th Street
La Grande, Oregon

January 1, 1973

LEGEND
( ) Data of Record.
o Found monuments as indicated.
• Set 5/8" x 30" Steel Rods.
——·—Quarter section line.

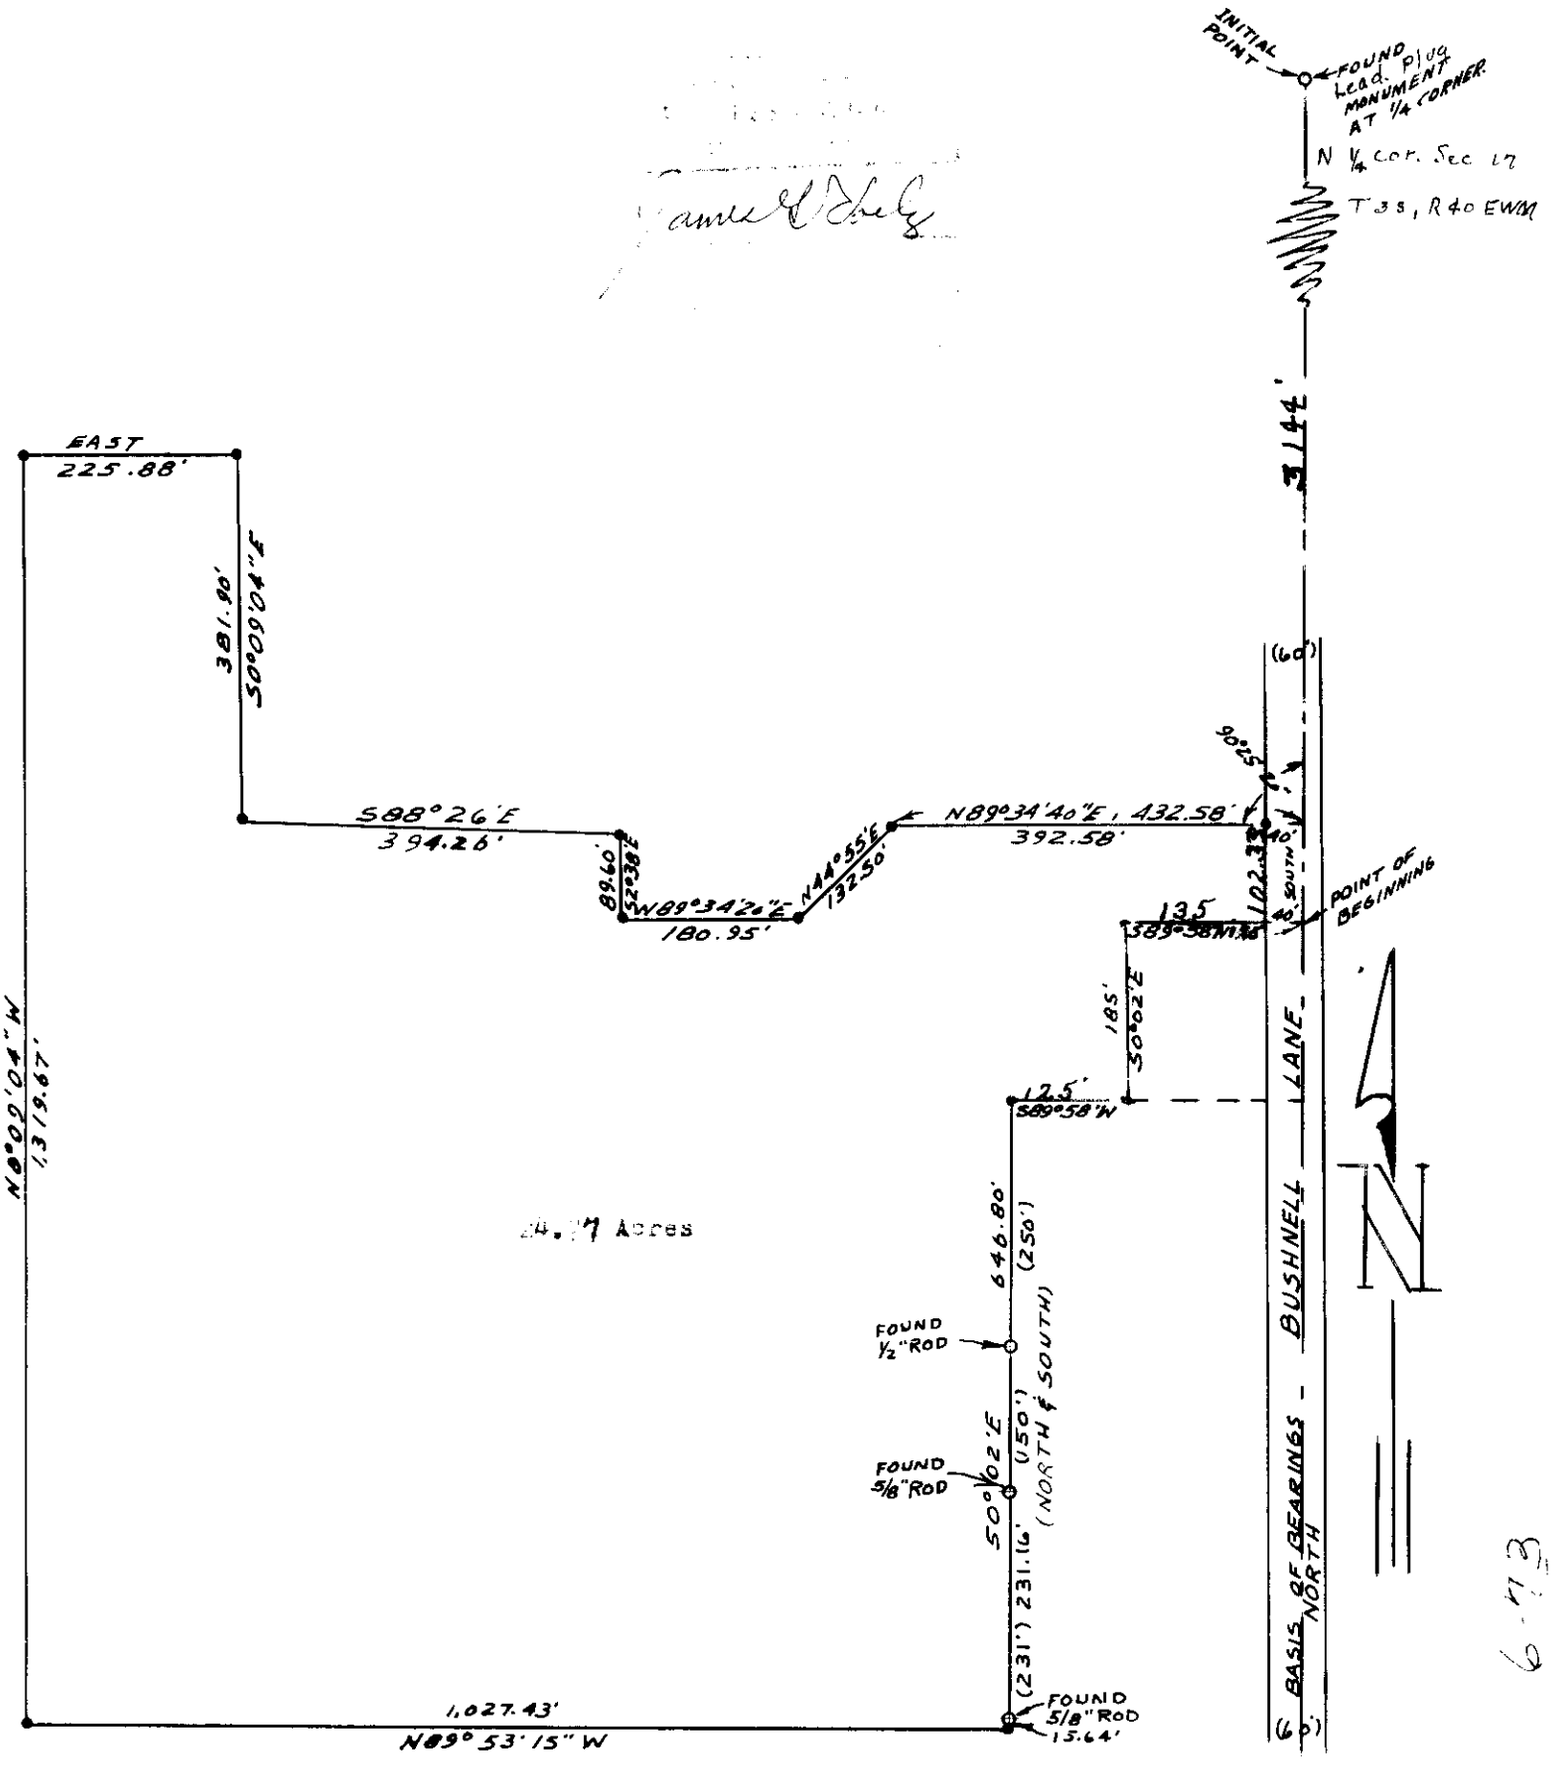

6-73