


Survey for
 Bill Thomas Real Estate
 1203 1/2 Adams Avenue
 La Grande, Oregon

January 17, 1973

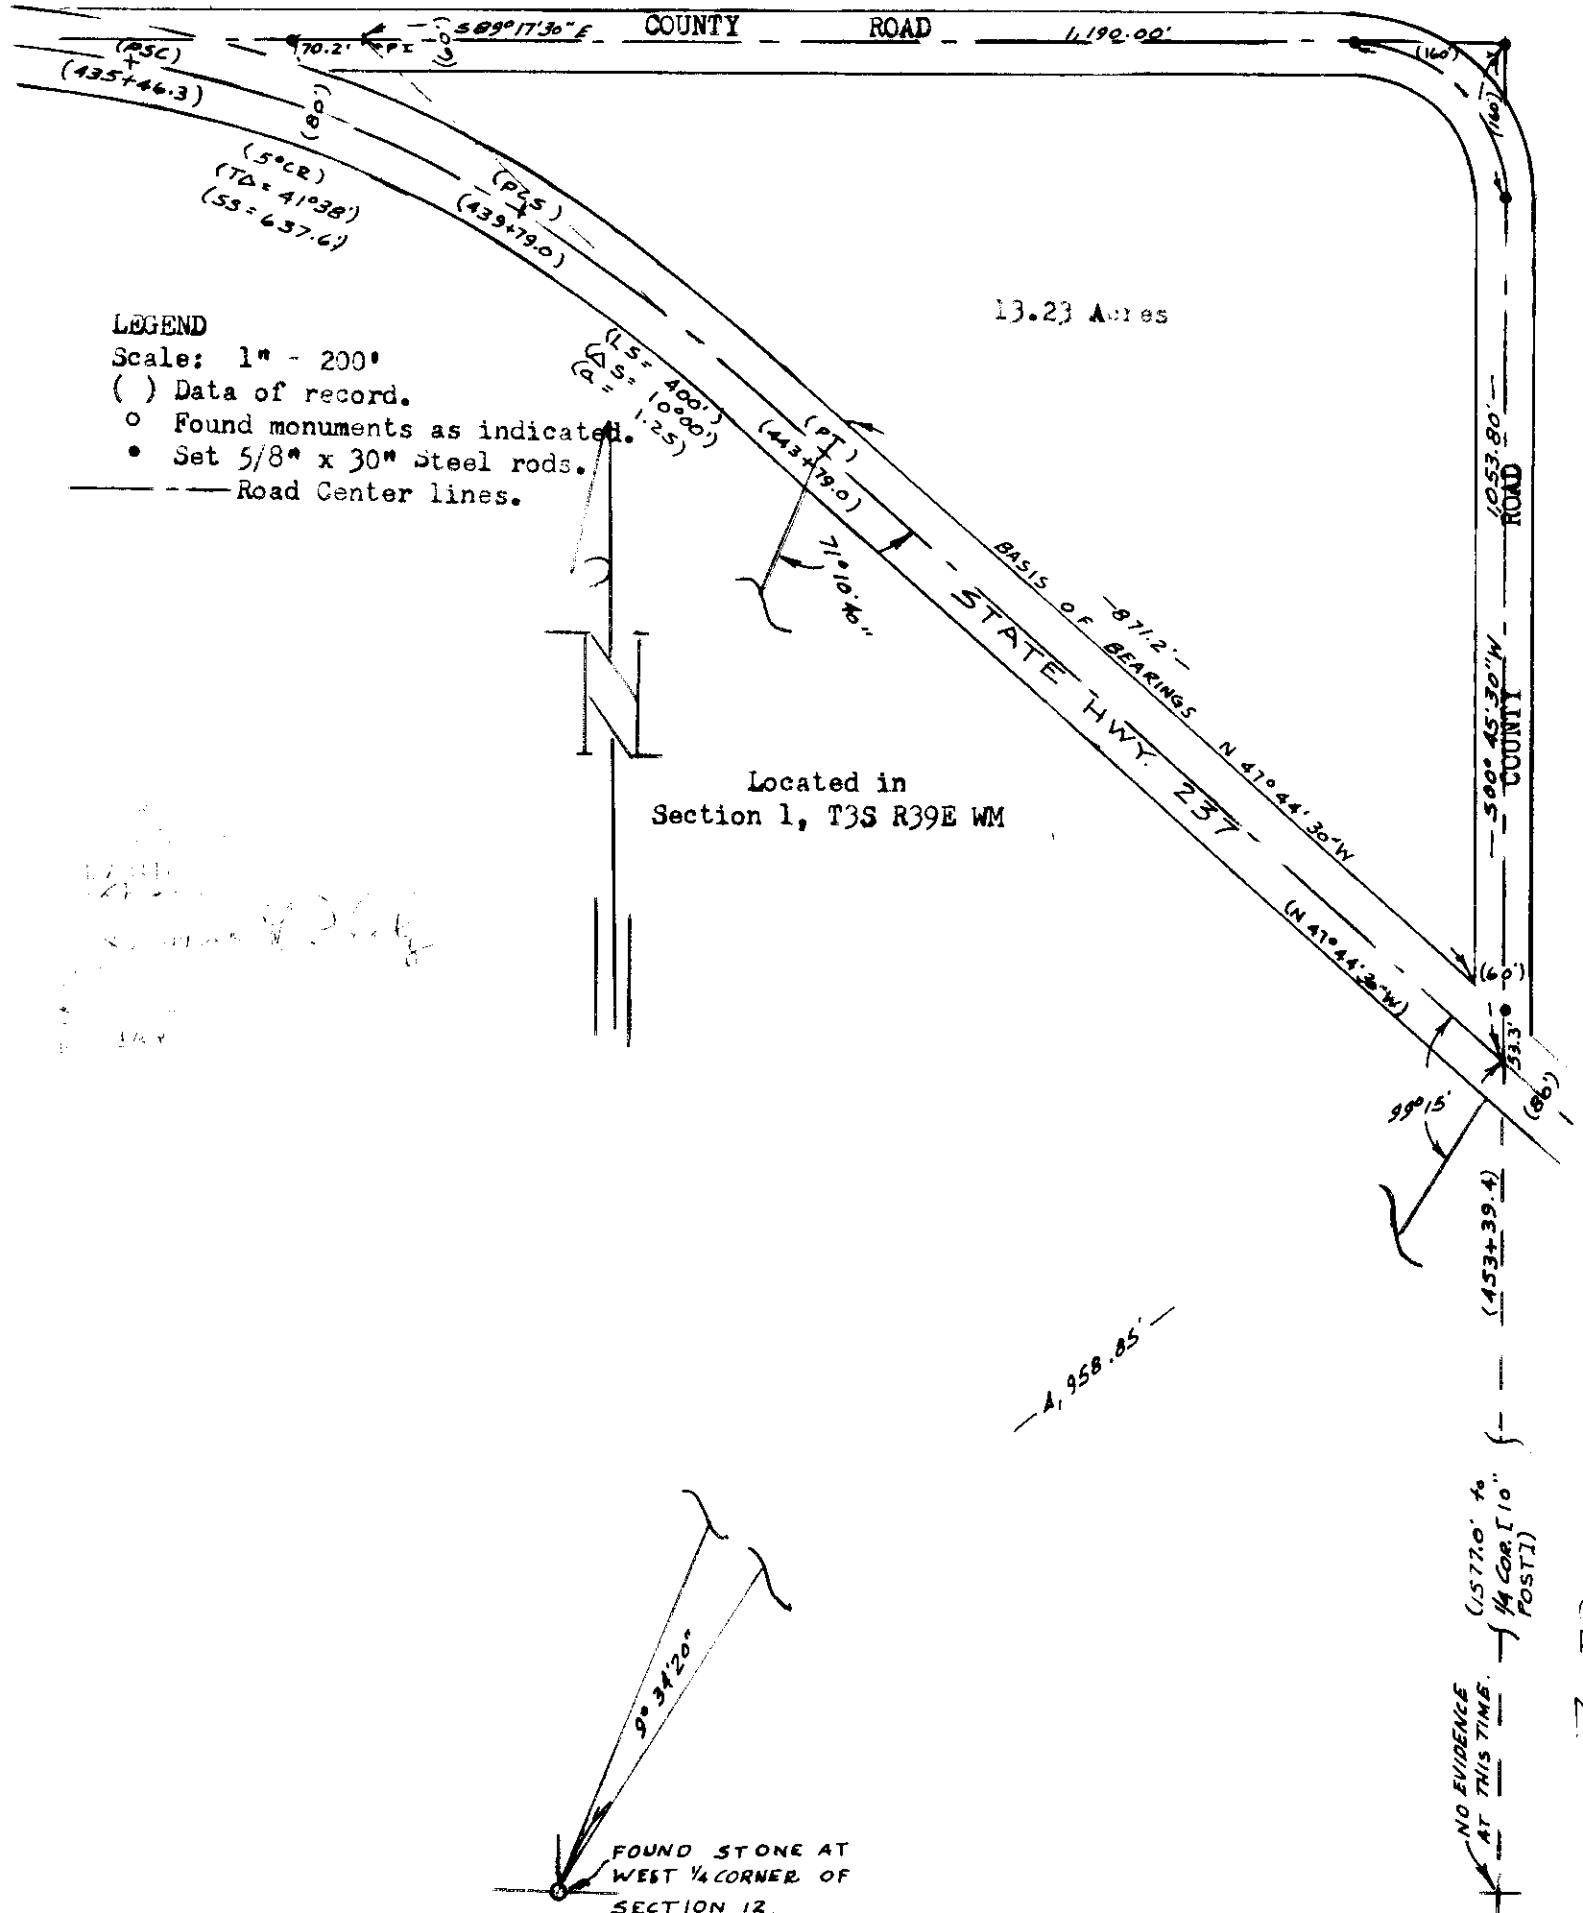

7-73