Survey for
Dick Conklin
Cove, Oregon

January 28. 1973

LEGEND

Scale: 1" = 60'
( ) Data Of Record.
○ Found Monuments as indicated
● Set 5/8" x 30" steel rods.
□ Angle Iron in Concrete.
—o— Power Poles.
——— - —— Center line of roads.
Basis of Bearings: As South Line Section 15 being S 89° 54' W.
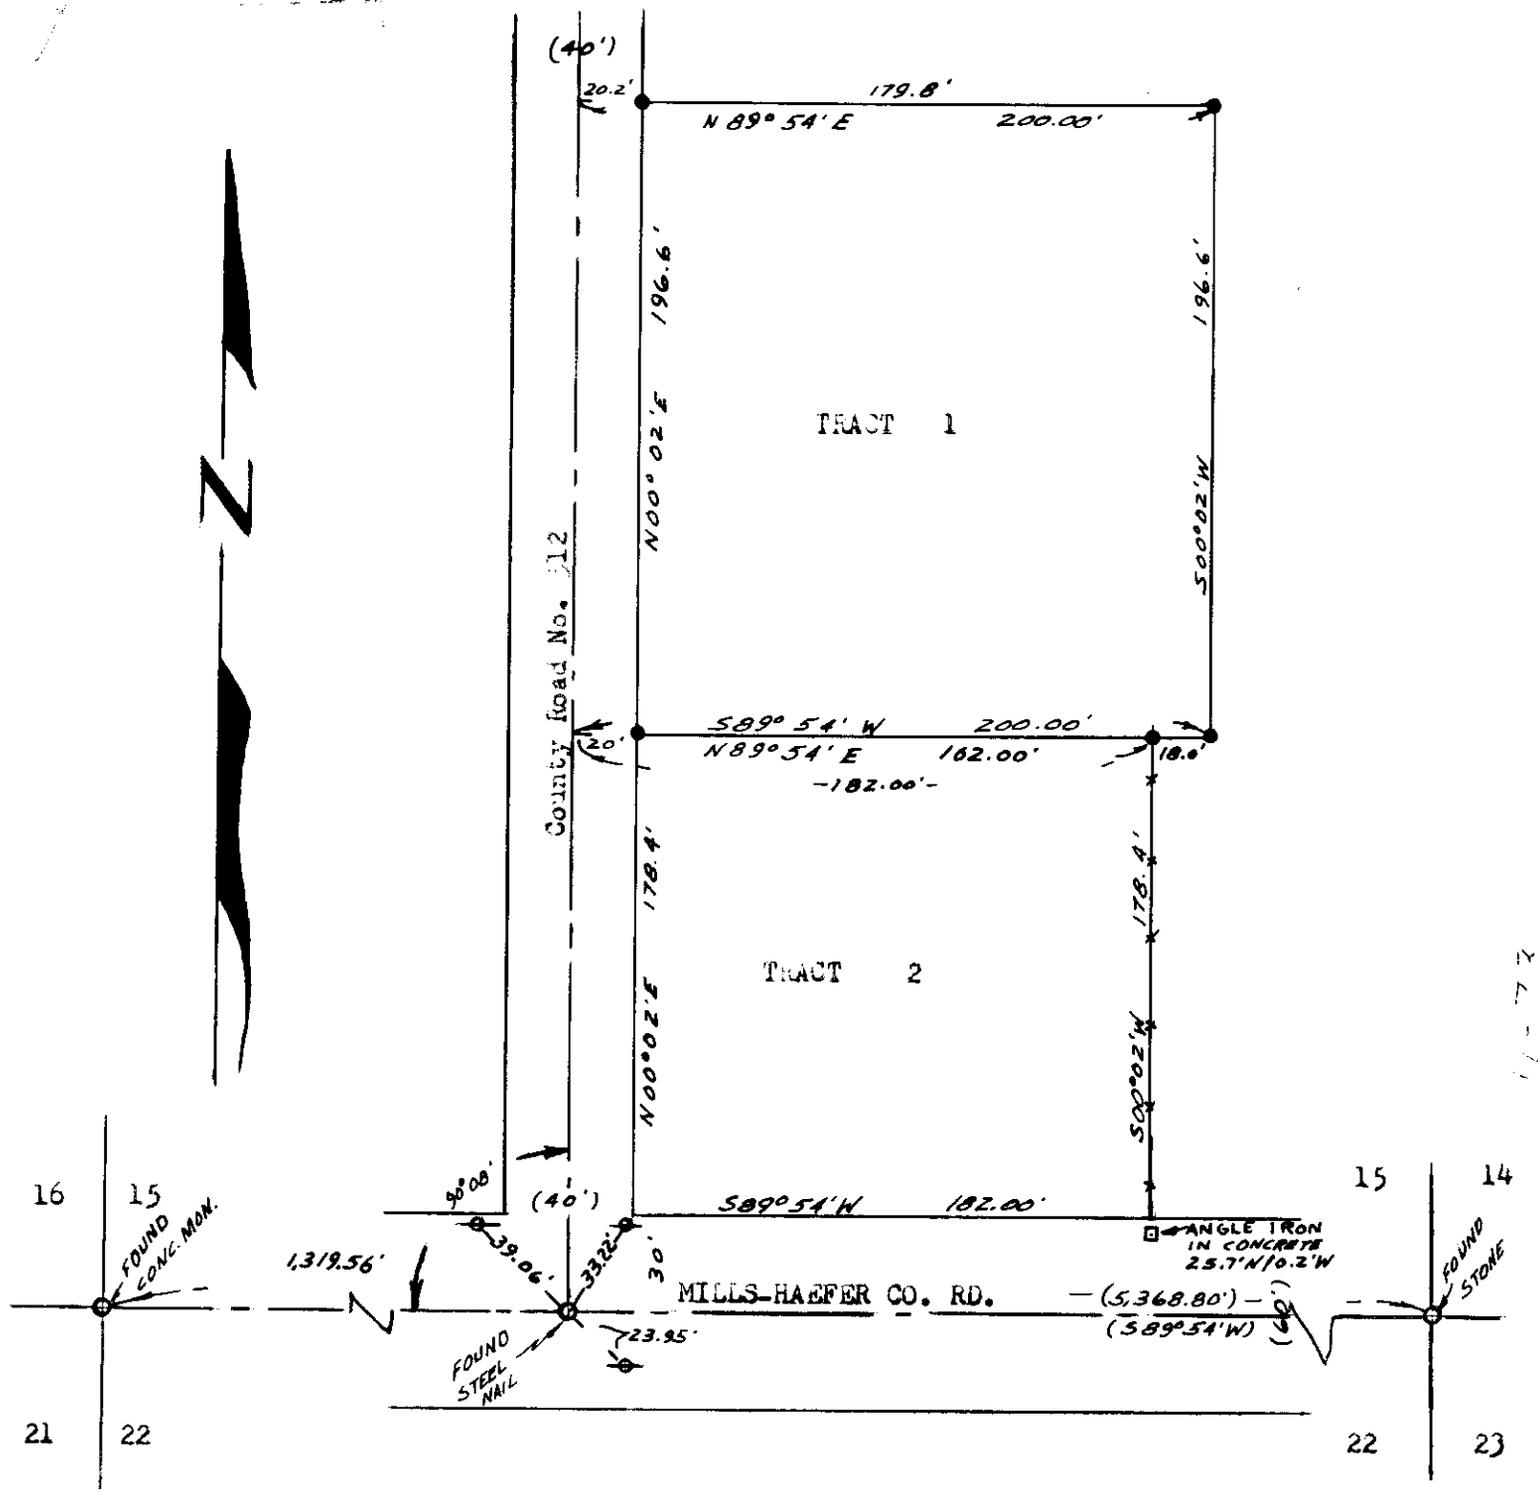
Located in SE¼SW¼ of Section 15, T3S R4OE WM