

Survey for:

Jack Getz  
North Powder, Oregon  
February 5, 1973

LEGEND


Scale: 1"=60'

( ) Data of Record.

• Set 5/8" x 30" Steel Rods.

○ Found monuments as indicated.

--- Street Center Lines.

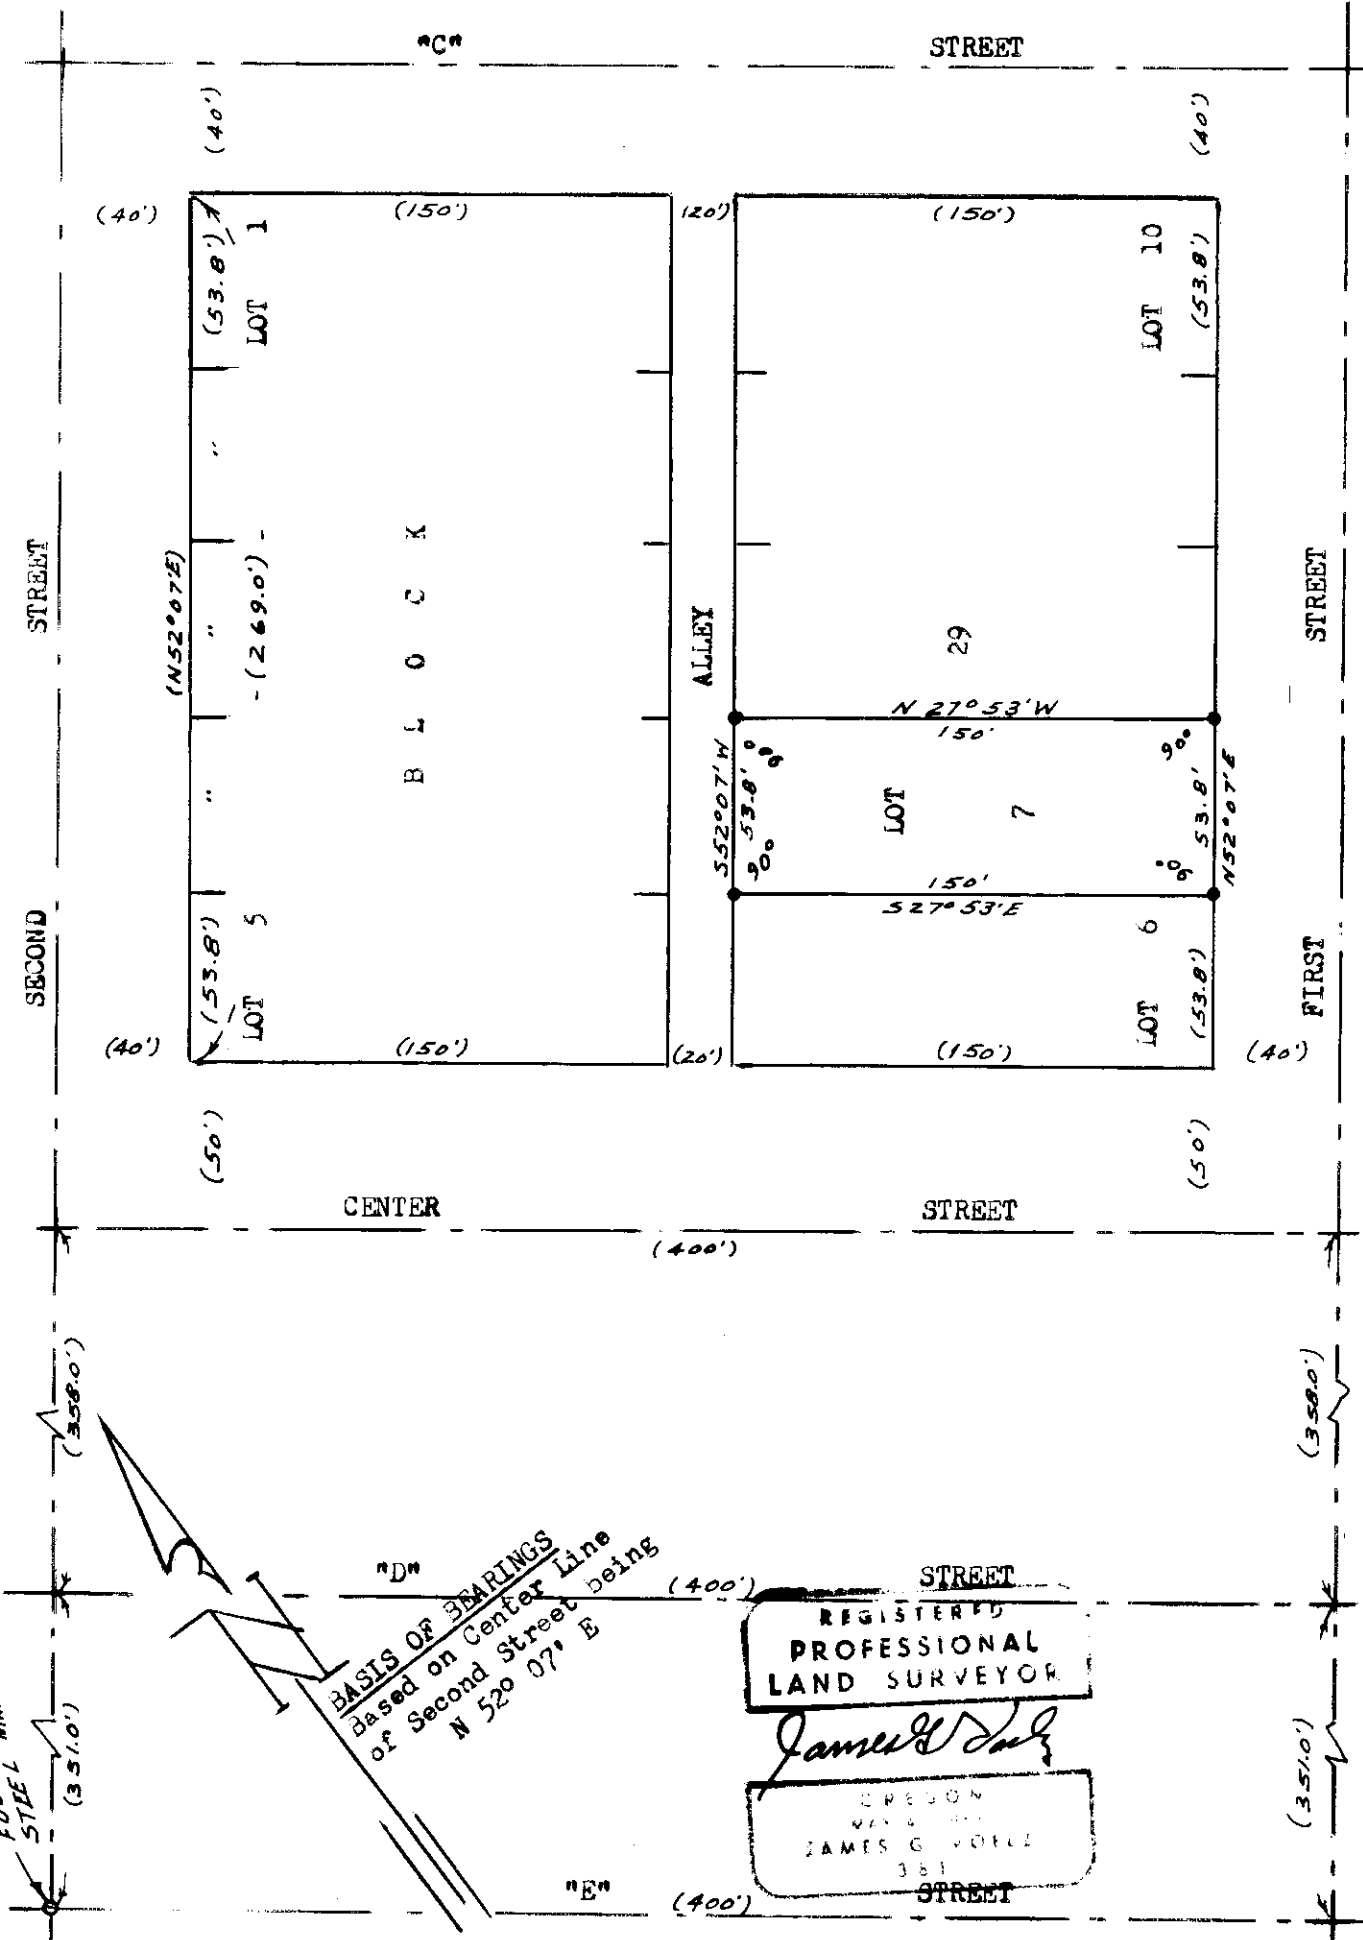

12-73