


Survey for  
 RONALD GROSS  
 1805 "U" Avenue  
 La Grande, Oregon

February 5, 1973

Located in NE $\frac{1}{4}$ SW $\frac{1}{4}$  of section 33, T2S R38E WM

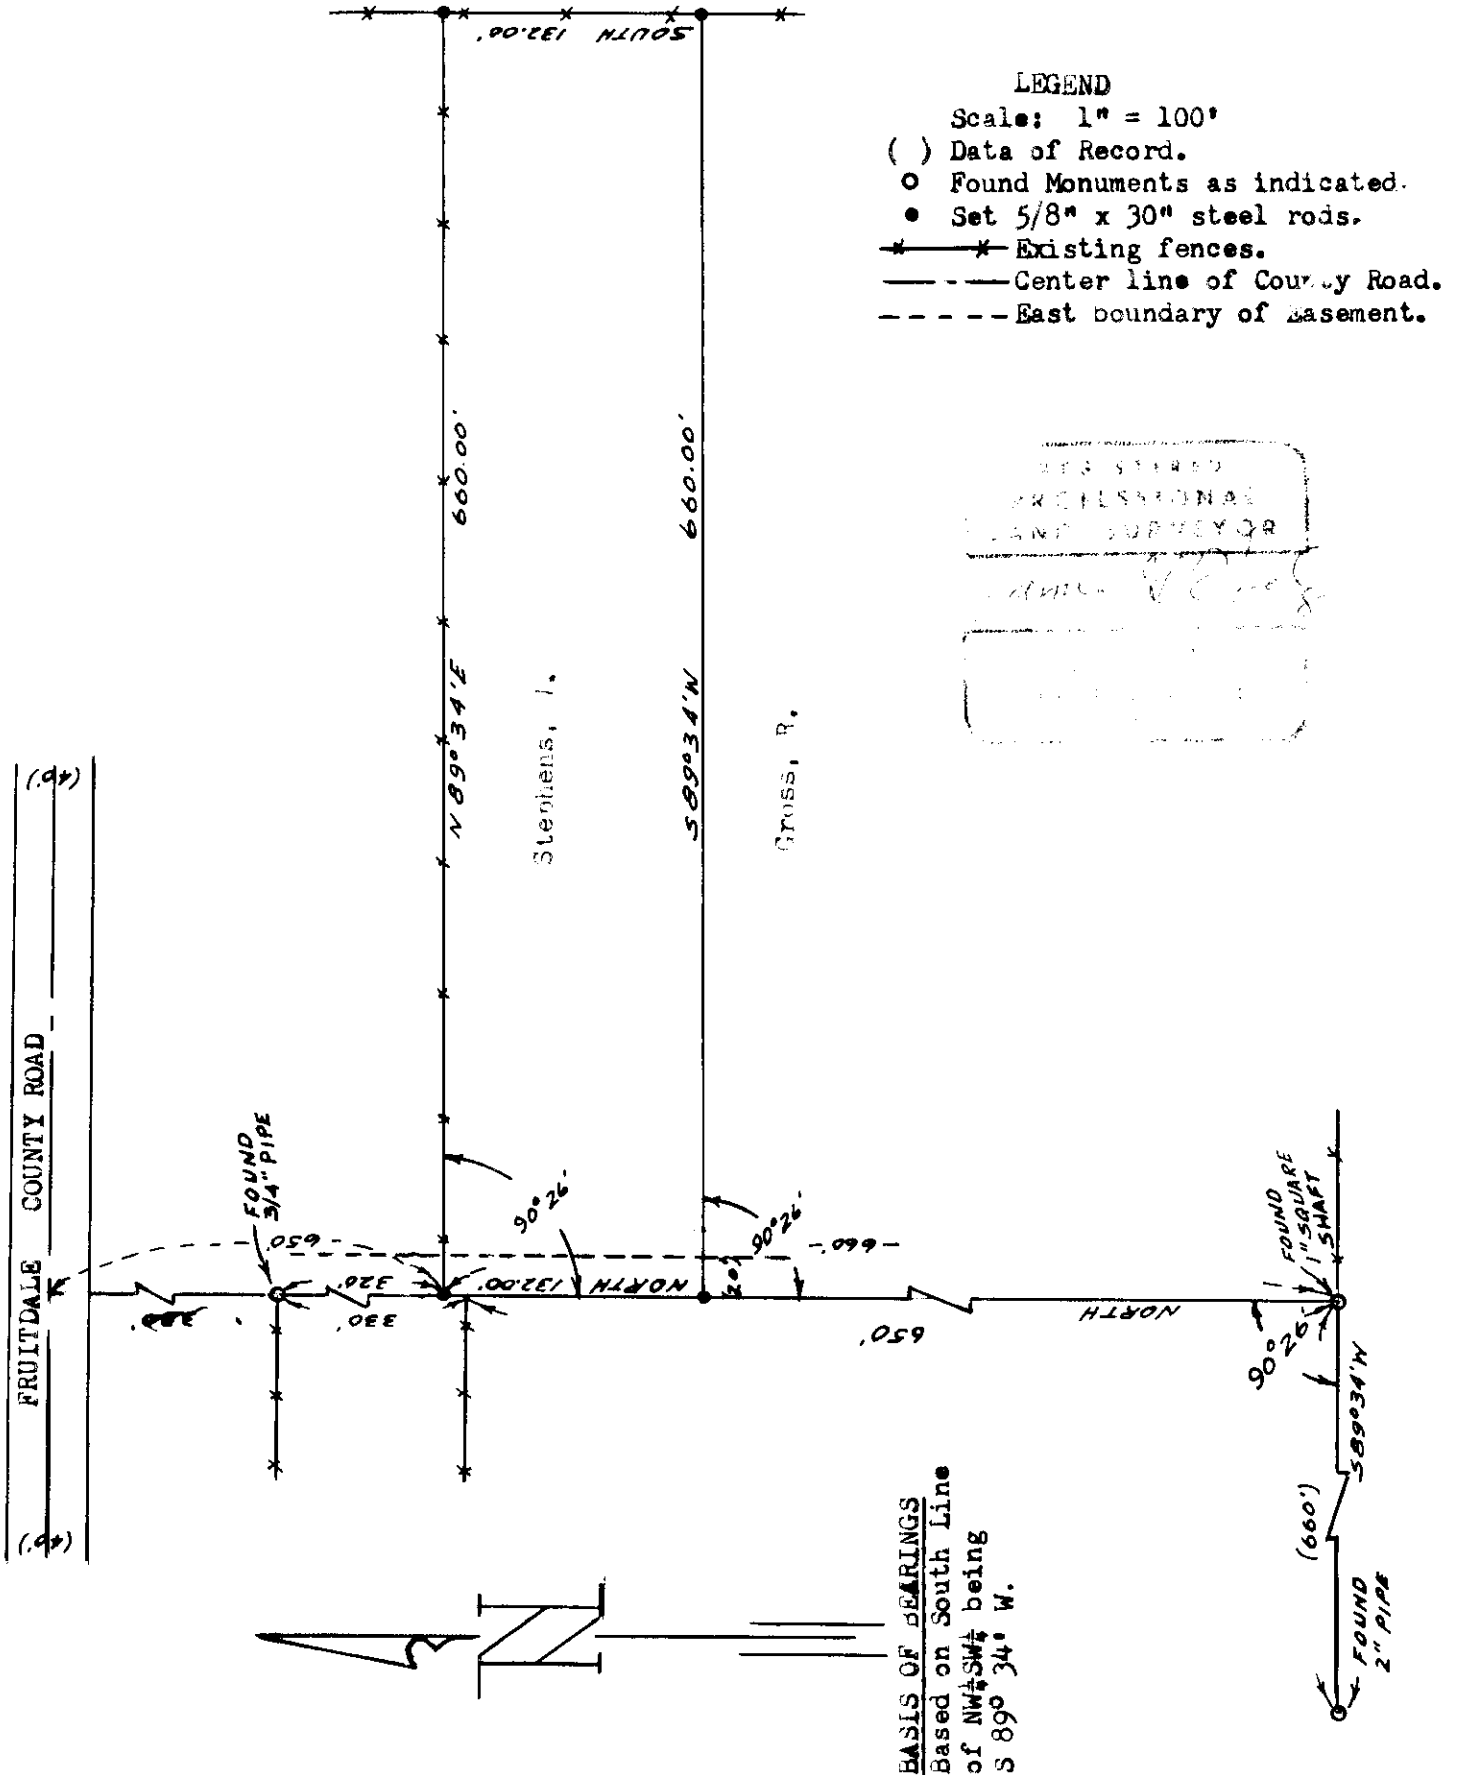

13-73