


Bill Jeffers
 Rt. #3 Box 3556
 La Grande, Oregon

Feb. 5, 1972

LEGEND

- () data of record.
 - ~ set 5/8"x30" steel rod.
 - set R.R. spike.
 - corner of record found.
- scale 1" = 50'

Located in SW 1/4 NE 1/4 of Section 7
 T 35 R 38 E W 11

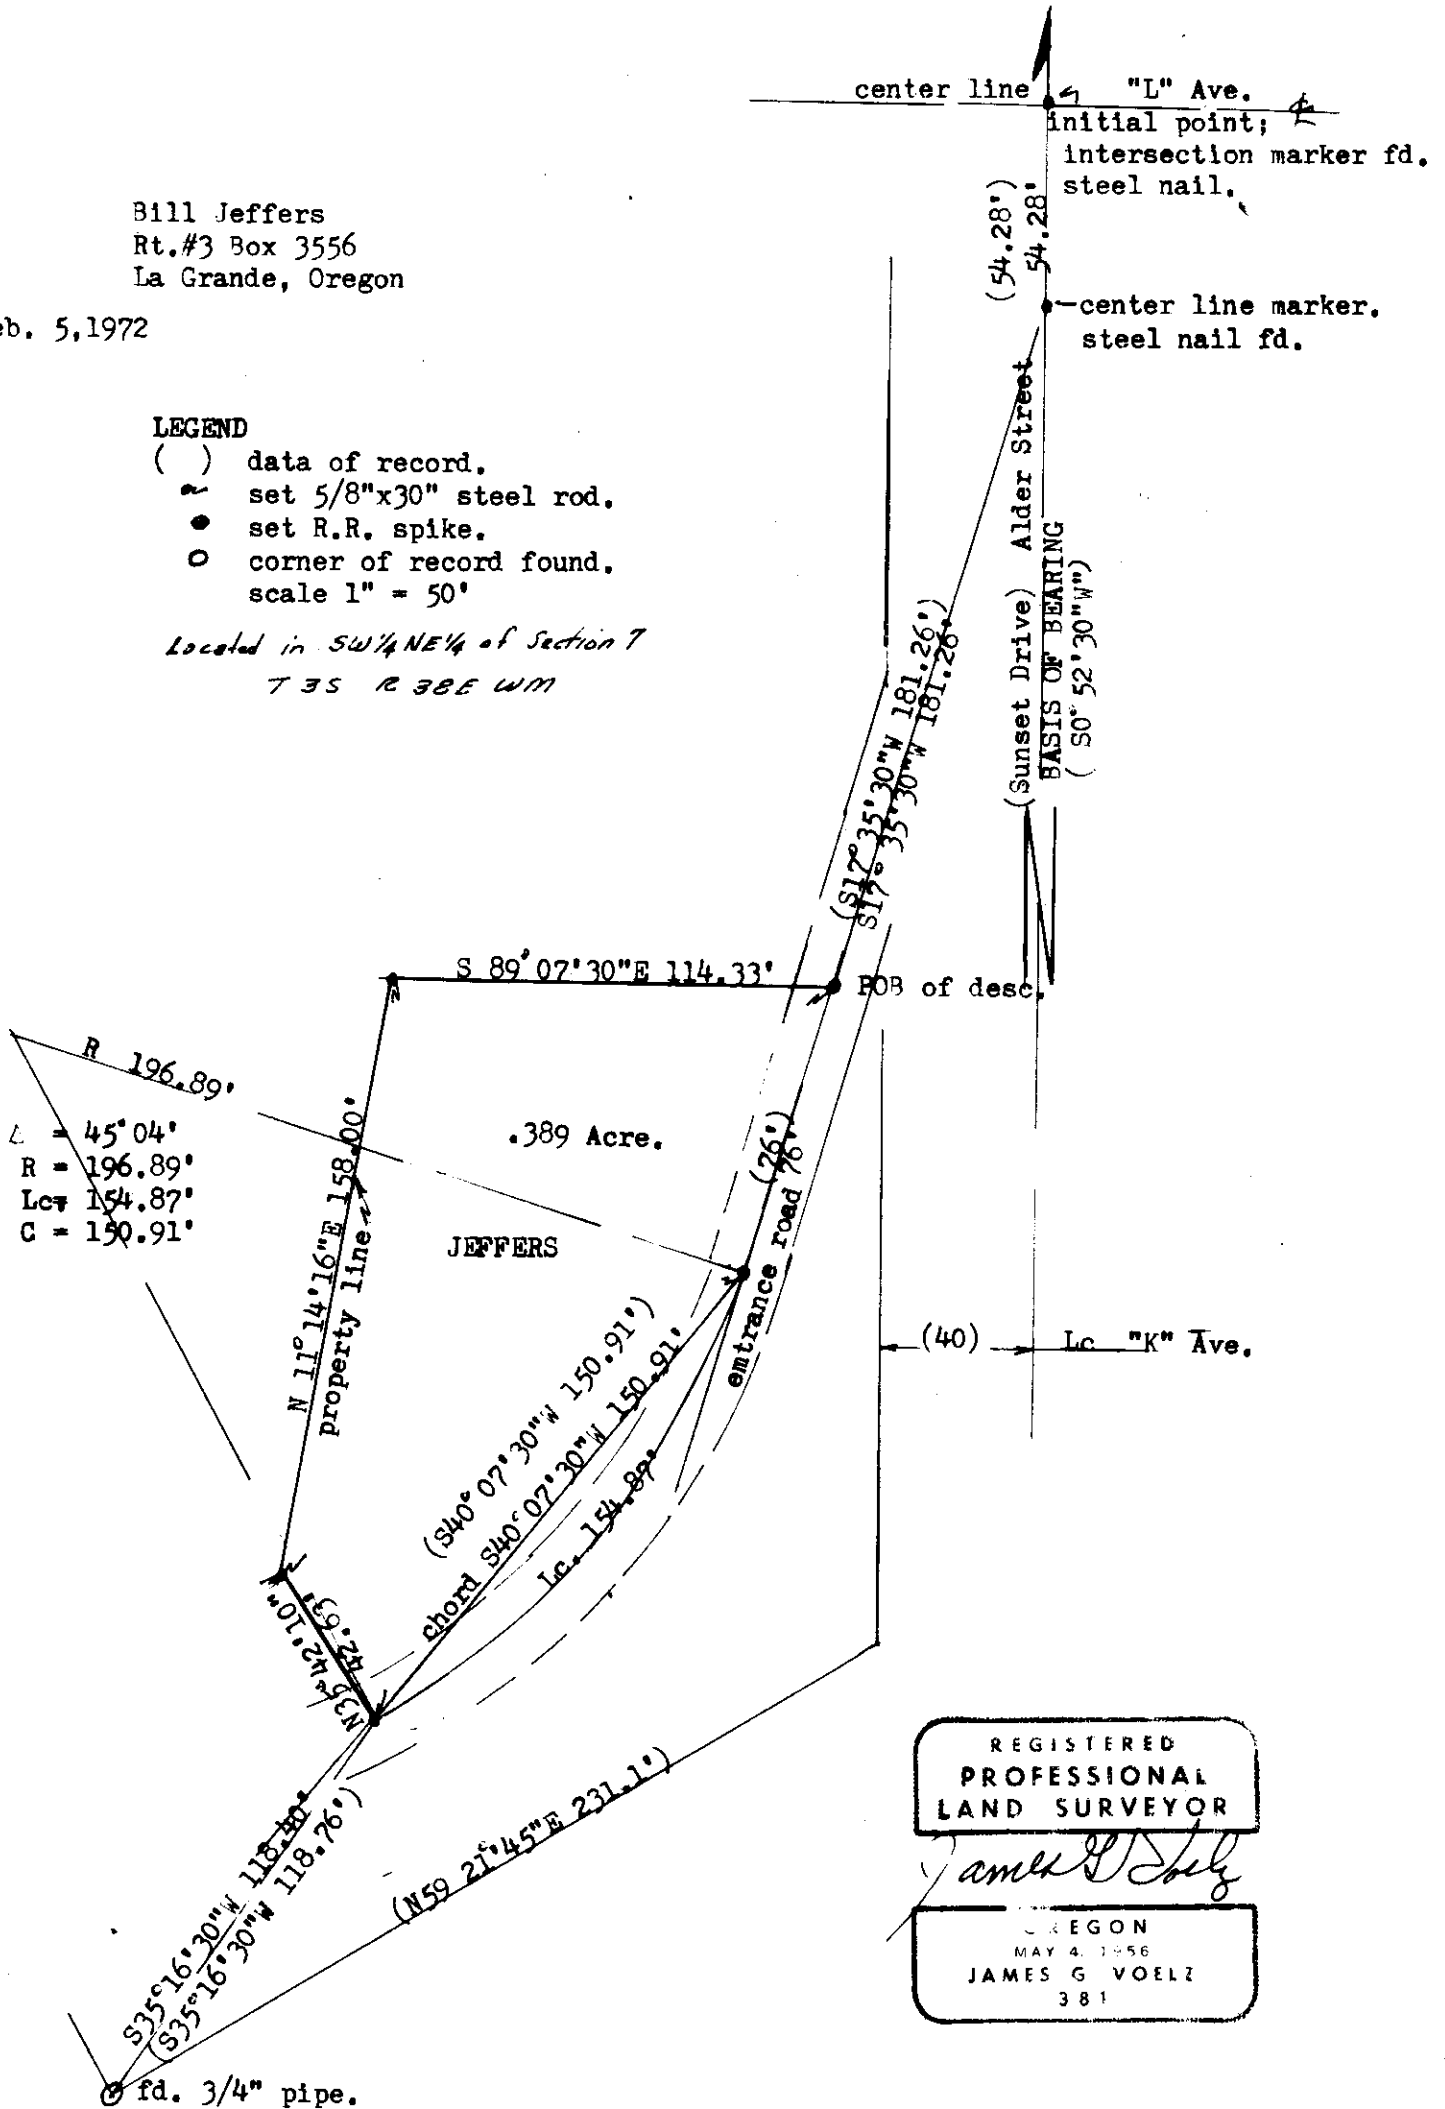

REGISTERED
 PROFESSIONAL
 LAND SURVEYOR

James G. Voelz

OREGON
 MAY 4 1956
 JAMES G. VOELZ
 381

26-73